


SHEET INDEX

SHEET	DESCRIPTION
C1	GRADING & DRAINAGE PLAN, DETAILS
C2	DRIVEWAY PROFILE, CROSS SECTIONS
C3	WATER POLLUTION CONTROL PLAN
C4	TOPOGRAPHIC MAP
C5	SAN MATEO COUNTY BMP SHEET

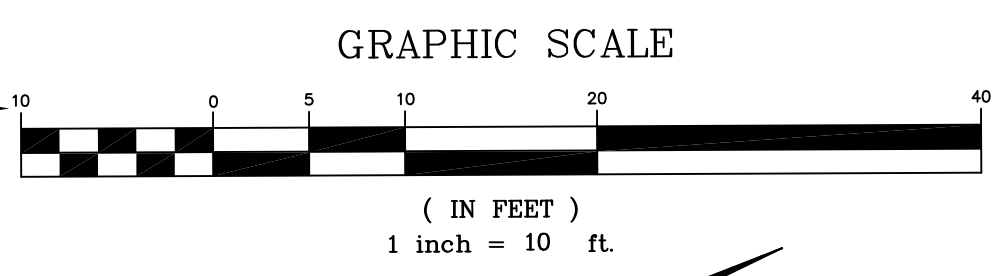

GENERAL NOTES

- THE INTENT OF THIS PLAN IS TO PROVIDE FOR GRADING AND DRAINAGE IMPROVEMENTS IN ACCORDANCE WITH THE REQUIREMENTS OF SAN MATEO COUNTY AND THE GEOTECHNICAL INVESTIGATION PREPARED BY POLLAK ENGINEERING, INC(DATED DECEMBER 1, 2021).
- PRIOR TO EXCAVATION, CONTRACTOR SHALL LOCATE ALL UNDERGROUND UTILITIES. CALL 811 TO HAVE UTILITIES LOCATED AND MARKED.
- STORM DRAIN PIPE SHALL BE POLY VINYL CHLORIDE CONFORMING TO ASTM D 3034, SDR 35 OR APPROVED EQUIVALENT SMOOTH WALL PIPE. CALIFORNIA DEPARTMENT OF TRANSPORTATION (CALTRANS) STANDARD SPECIFICATIONS.
- CONTRACTOR SHALL TIE ALL DOWNSPOUTS INTO THE NEW STORM DRAIN SYSTEM WITH WATER TIGHT 4" DIAMETER RAIN WATER LEADERS. PROVIDE AIR GAP WHERE LEADER GOES UNDERGROUND.
- CONTRACTOR SHALL GRADE THE INVERTS OF ALL DRAIN BOXES AND INSTALL ALL STORM DRAIN PIPING TO DRAIN SO AS TO ELIMINATE ALL STANDING WATER.
- CONTRACTOR SHALL GRADE TO PROVIDE 5% MINIMUM SLOPE AWAY FROM BUILDING FOR A MINIMUM DISTANCE OF 10 FEET IN LOCATIONS WHERE CONCRETE SWALE OR CONCRETE FLAT WORK IS NOT INSTALLED, UNLESS OTHERWISE NOTED.
- DIRT AND DEBRIS SHALL NOT BE WASHED INTO STORM DRAINAGE FACILITIES.
- AGGREGATE BASE SHALL BE CLASS 2 IN CONFORMANCE WITH SECTION 26 OF THE STATE OF CALIFORNIA DEPARTMENT OF TRANSPORTATION (CALTRANS) STANDARD SPECIFICATIONS.
- CONTRACTOR SHALL BE RESPONSIBLE FOR JOB SITE SAFETY 24 HOURS A DAY DURING THE COURSE OF CONSTRUCTION, INCLUDING THE SAFETY OF ALL PERSONS AND PROPERTY.
- ASPHALT CONCRETE (AC) SHALL BE 1/2" MAXIMUM TYPE "B" IN CONFORMANCE WITH SECTION 39 OF THE STATE OF CALIFORNIA DEPARTMENT OF TRANSPORTATION (CALTRANS) STANDARD SPECIFICATIONS. ASPHALT SHALL BE PG-6410 AND AMOUNT TO BE MIXED WITH THE AGGREGATE SHALL BE BETWEEN 5 AND 7 PERCENT BY WEIGHT OF DRY AGGREGATE. ASPHALT FOR AC CURBS SHALL BE PG-6410 WITH 3/8" MAXIMUM SIZE AGGREGATE.

LEGEND

4" PVC RAIN WATER LEADER FROM DOWN SPOUT	RL
DOWN SPOUT LOCATION	DS
EXISTING FINISH FLOOR	EXST
NEW FINISH GRADE	100.7
EXIST. GRADE	<100.7>
CONCRETE DRIVEWAY OR STOOP (STRUCTURAL DESIGN BY OTHERS)	[Pattern]
INSTALL CHRISTY V64 DRAIN BOX AND GRATE	[Symbol]
AREA OF DISTURBANCE (5,290 SQUARE FEET)	[Pattern]
EAVE LINE	[Symbol]
PROPERTY LINE	RL
4" RL @ 1% MIN	RL
EXST ELEVATION CONTOUR (1' INTERVAL)	485
EXST ELEVATION CONTOUR (5' INTERVAL)	485
GRADE TO DRAIN	[Symbol]

IMPERVIOUS AREA CALCULATIONS

EXISTING IMPERVIOUS AREA	
DRIVEWAY	465* SF
HOUSE	2,061* SF
CONCRETE PATIO	510* SF
CONCRETE WALK(REMOVE)	176* SF
CONCRETE WALK(REMAIN)	152 SF
TOTAL EXISTING IMPERVIOUS AREA	3,364 SF
PROPOSED IMPERVIOUS AREA	
NEW HOUSE & STOOP	2,467 SF
DRIVEWAY	431 SF
TOTAL PROPOSED IMPERVIOUS AREA	2,898 SF
IMPERVIOUS AREA TO BE REMOVED	3,212 SF
NEW IMPERVIOUS AREA	2,898 SF
NET IMPERVIOUS AREA TO BE REMOVED	314 SF

*IMPERVIOUS AREA TO BE REMOVED



ESTIMATED EARTHWORK (NOT FOR BIDDING PURPOSES)

CUT	
AT DRIVEWAY & FRONT YARD	5 CUBIC YARDS
AT HOUSE	82 CUBIC YARDS
HOUSE FOUNDATION	15 CUBIC YARDS
TOTAL CUT	102 CUBIC YARDS
FILL	
AT DRIVEWAY & FRONT YARD	5 CUBIC YARDS
TOTAL FILL	5 CUBIC YARDS

DOES NOT INCLUDE SHRINKAGE FACTOR FOR FILL OR ANY FILL KEYWAYS




PROPOSED IMPROVEMENT NOTES

- REMOVE ALL CONCRETE AT FRONT OF HOUSE; DRIVEWAY STOOP AND CONCRETE WALKS
- REMOVE CONCRETE WALK AND PATIO
- RETAINING WALL TO REMAIN
- CONCRETE WALK TO REMAIN
- INSTALL SILT AND DEBRIS TRAP DRAIN BOX SEE DETAIL A ON THIS SHEET
- INSTALL INFILTRATION TRENCH 4' WIDE X 5' DEEP X 17' LONG, DETAIL B THIS SHEET

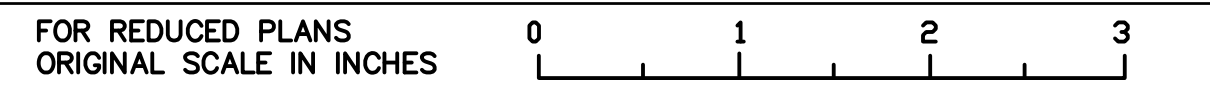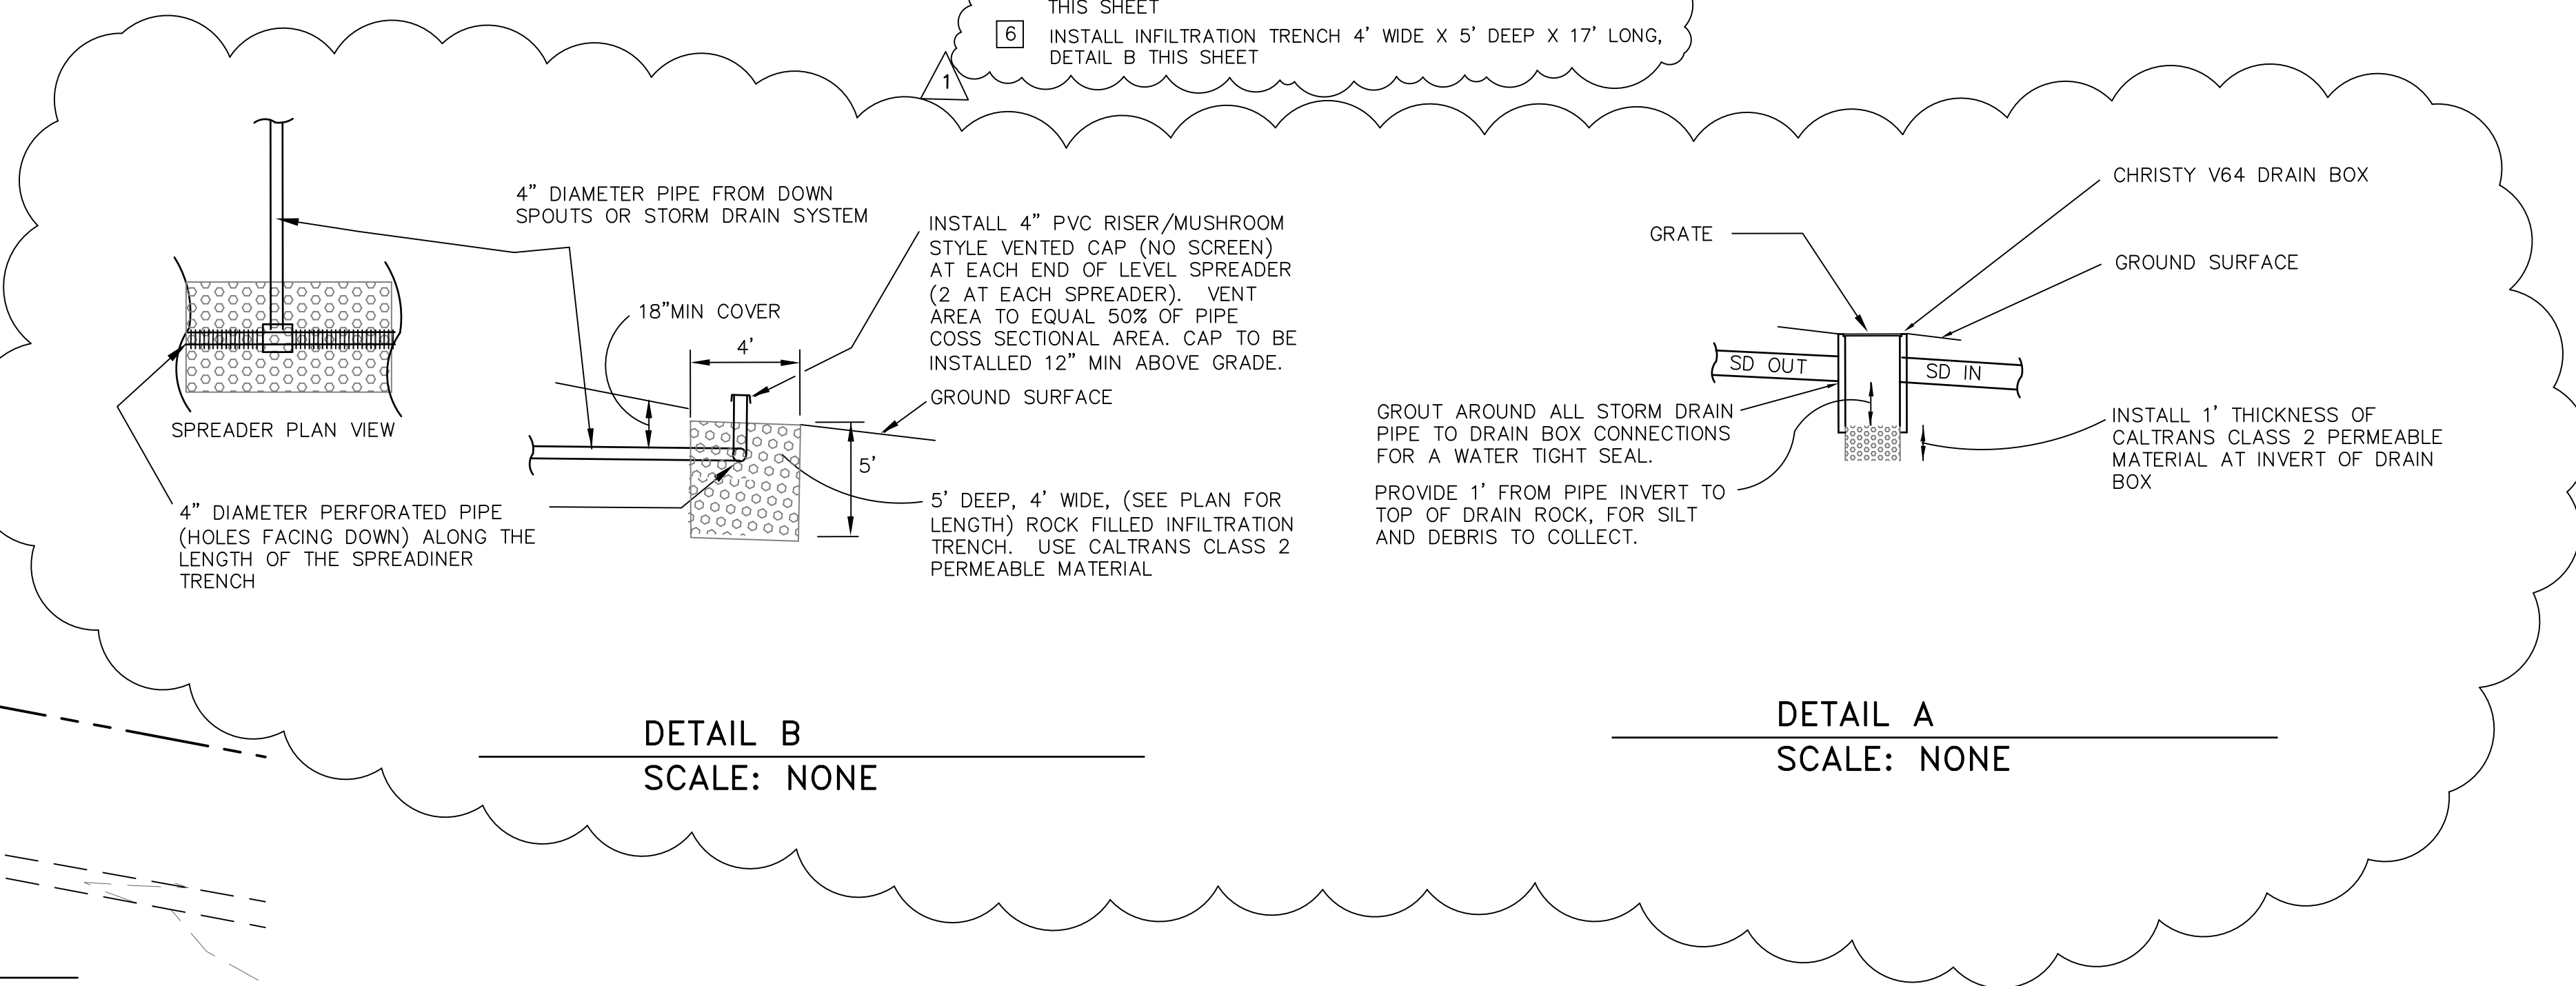


SHEET NAME: DRAWING NAME:

BY	REVISION	DATE	PROJECT ENGINEER
MFG	RESPOND TO PLAN CHECK COMMENTS	8/1/22	MFG Engineers, Inc
	REVISE INFILTRATION TRENCH		PO BOX 1914
	DETAIL BASED ON NEW STORM DRAIN CALCULATIONS		APTOS, CA. 95001
			(831) 763-1661
			CEL (831) 601-9519
APN 057-011-111-34 GRADING & DRAINAGE PLAN 52 W. SUMMIT DRIVE, REDWOOD CITY, CA			
DRAWN: MFG			
CHECKED: MFG			
DATE: 4/22			
SCALE: 1"=10'			
JOB NO.			
SHEET			
C1 of 5			

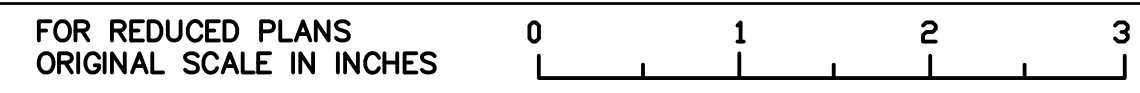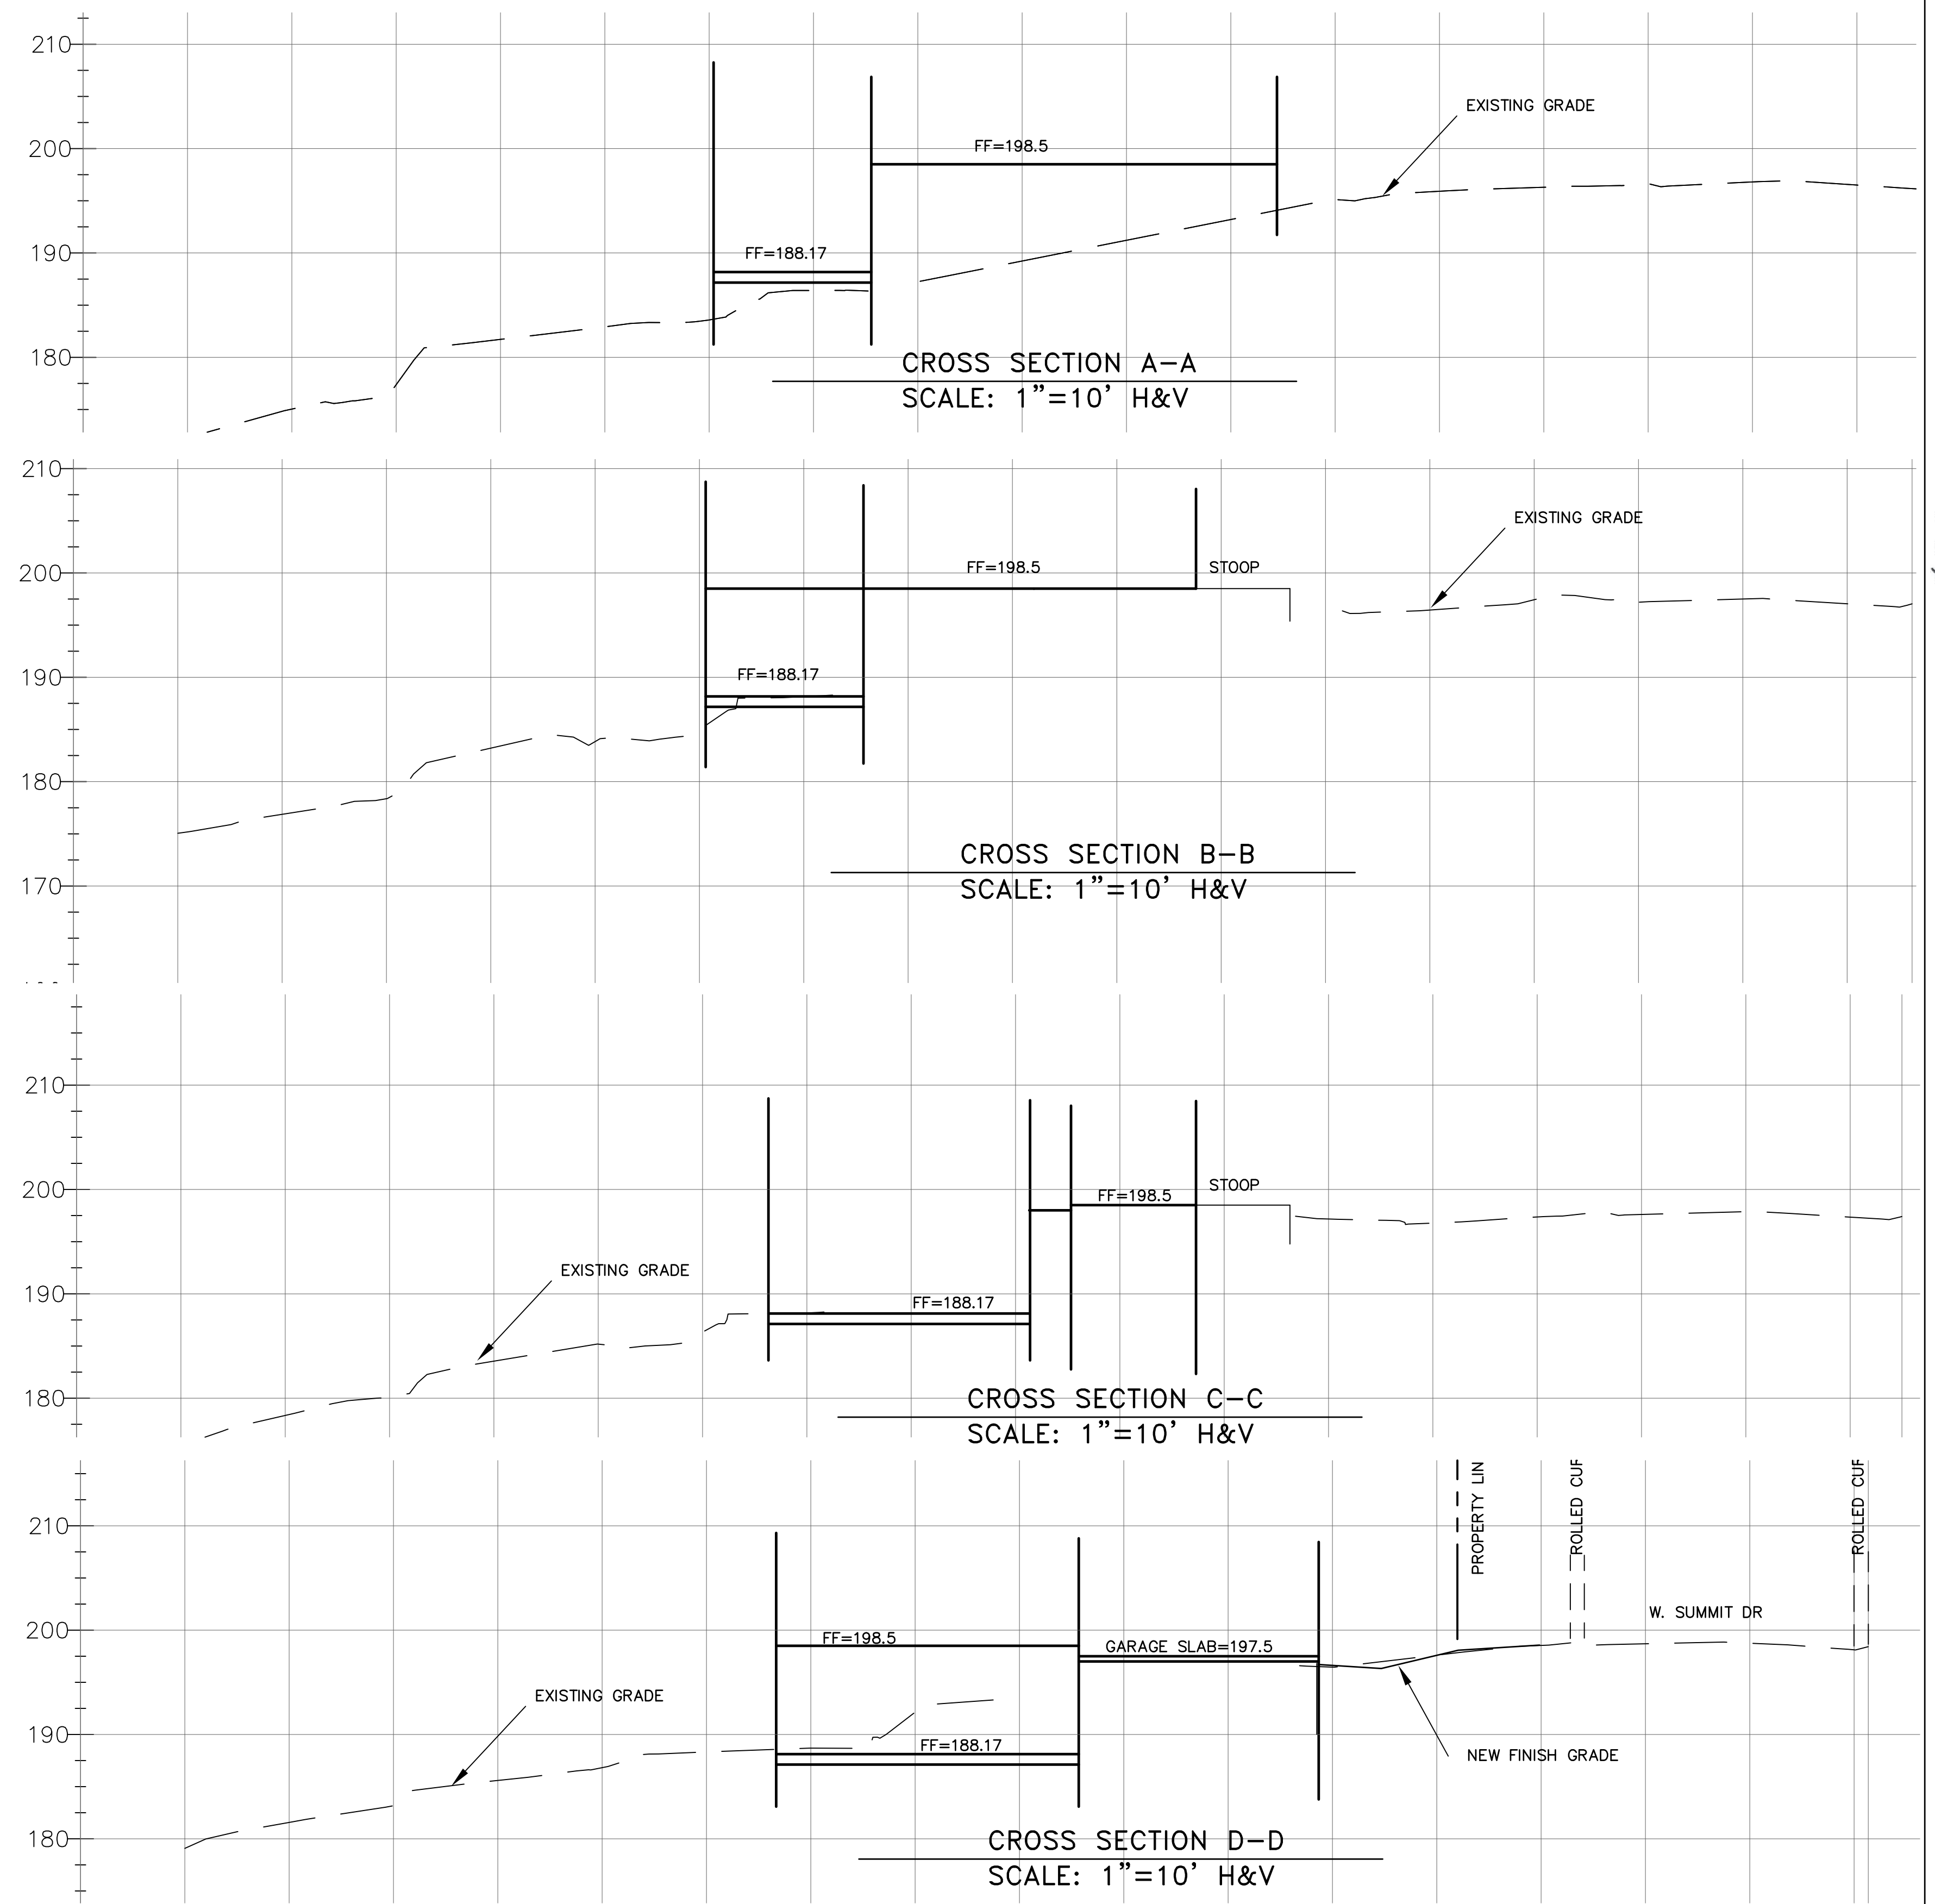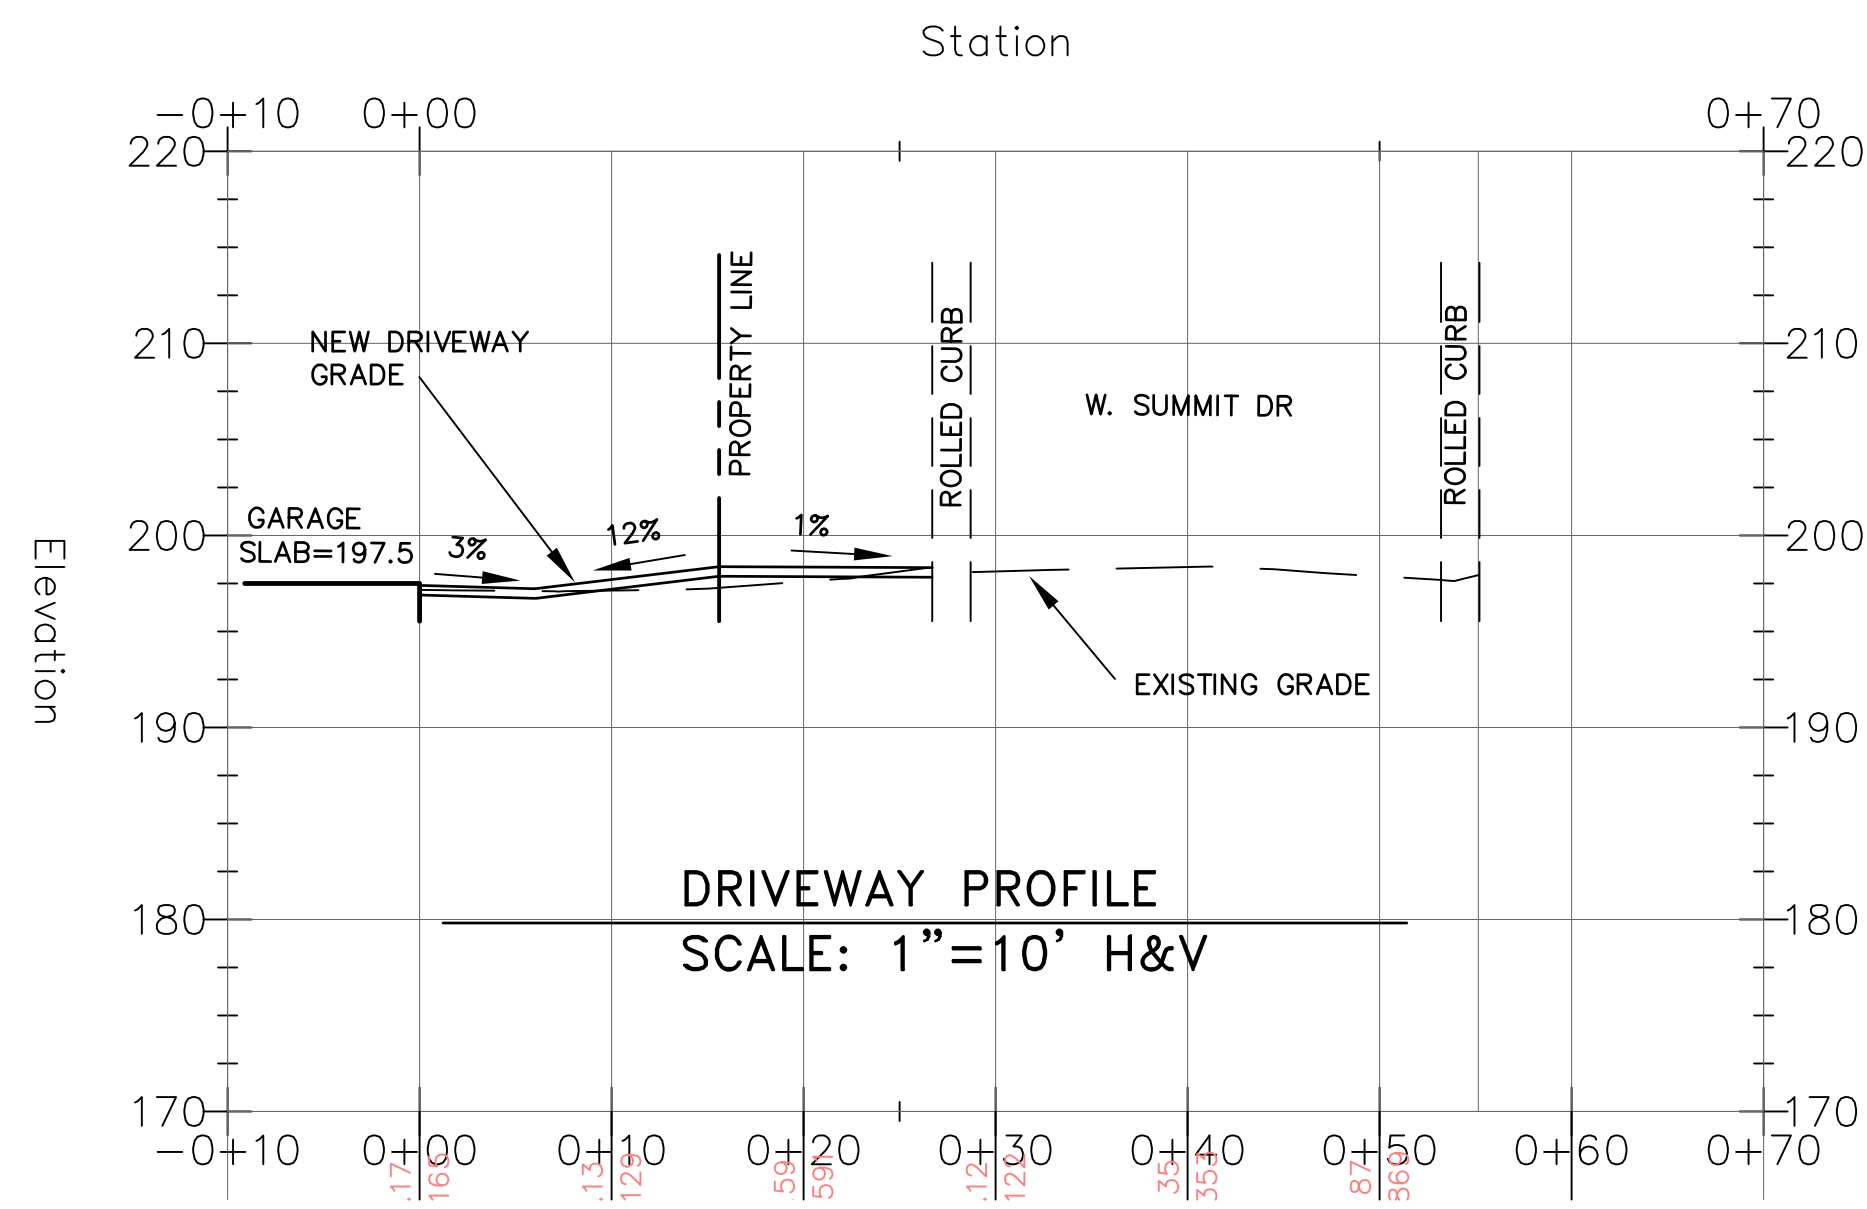

SHEET NAME: DRAWING NAME:

BY	
REVISION	
DATE	
PROJECT ENGINEER	MFG Engineers, Inc PO BOX 1914 APTOS, CA. 95001 (831) 763-1661 CEL (831) 601-9519
APN 057-011-111-34	PROFILES AND CROSS SECTIONS 52 W. SUMMIT DRIVE, REDWOOD CITY, CA
DRAWN: MFG	
CHECKED: MFG	
DATE: 4/22	
SCALE: 1"=10'	
JOB NO.	
SHEET	C2 OF 5

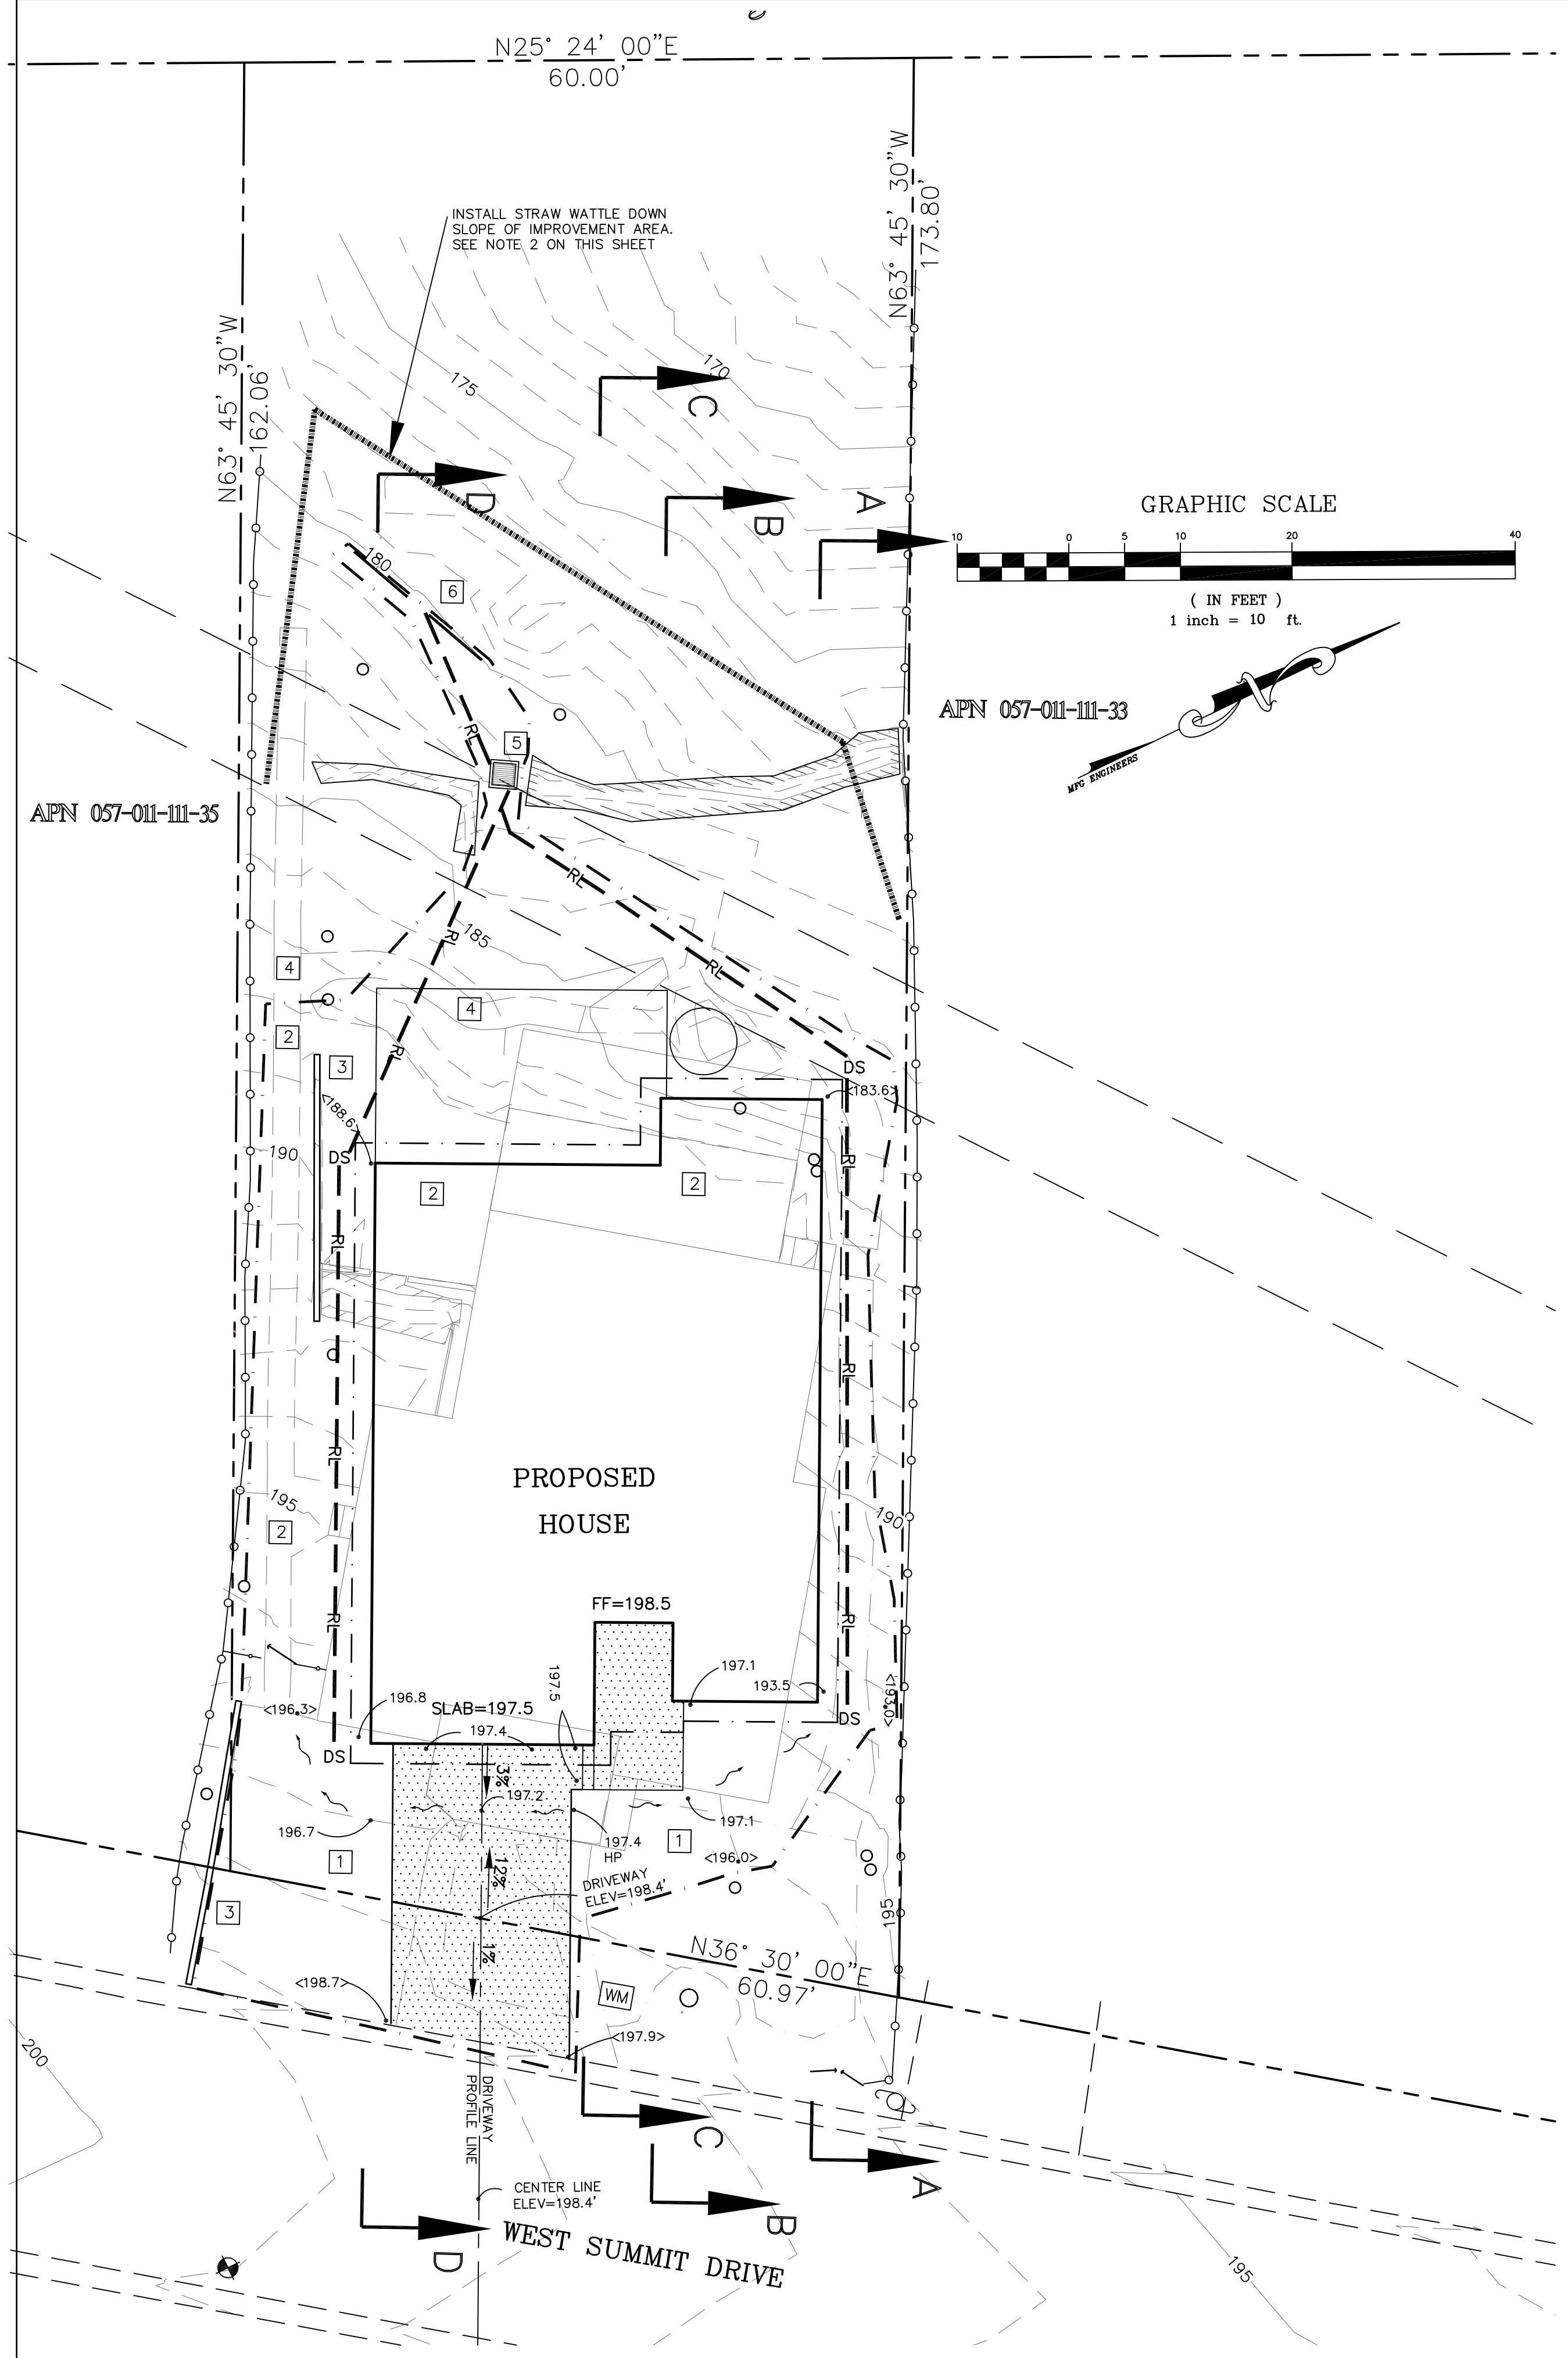

EROSION CONTROL REQUIREMENTS



THE FOLLOWING EROSION CONTROL AND HOUSE KEEPING MEASURES ARE INTENDED TO CONTROL THE RELEASE OF SILT, DUST, GARBAGE AND ANY OTHER POLLUTANTS FROM THE SITE OR INTO THE ATMOSPHERE AND SOIL DURING CONSTRUCTION. THESE MEASURES ARE INTENDED TO COMPLY WITH FEDERAL, STATE AND LOCAL REQUIREMENTS THROUGH THE USE OF BEST MANAGEMENT PRACTICES (BMP'S) LISTED BELOW.

1. **COVER OF BARE SOIL:** ONE OF THE FOLLOWING MEASURES SHALL BE USED TO COVER BARE SOIL DURING THE WINTER SEASON (OCTOBER 15TH TO APRIL 15TH);
 - SEED AND STRAW MULCH**
SEED AND STRAW MULCH SHALL BE USED IN DISTURBED AREAS AS A MEANS FOR TEMPORARY EROSION CONTROL UNTIL PERMANENT STABILIZATION IS ESTABLISHED. IT MAY BE USED ON SLOPES UP TO 3:1 H:V (33%).
 - SEED AND STRAW MULCH SHALL CONSIST OF SPREADING SEED (A MINIMUM OF 5 LBS/1000 SQ FT) OVER DISTURBED AREAS AND THEN PLACING A UNIFORM LAYER OF STRAW (2-3 BALES/1000 SQ FT) AND INCORPORATING IT INTO THE SOIL WITH A STUDDED ROLLER OR ANCHORING IT WITH A TACKIFIER STABILIZING EMULSION.
 - SEED SHALL BE ANNUAL WINTER BARLEY AND THE STRAW SHALL BE DERIVED FROM RICE BARLY OR WHEAT.
 - EROSION CONTROL BLANKETS (GEOTEXTILE OR EROSION MATS)
EROSION CONTROL BLANKETS ARE REQUIRED ON SLOPES STEEPER THAN 3:1, HOWEVER THEY MAY BE USED ON GROUND SURFACES FLATTER THAN 3:1 IN LIEU OF SEED AND STRAW MULCH. SEEDING MUST BE PLACED ON THE DISTURBED GROUND PRIOR TO PLACEMENT OF THE EROSION CONTROL BLANKET AND DESCRIBED IN THE SEED AND STRAW MULCH SECTION ABOVE.
2. **SEDIMENT CONTROL:**
 - FIBER ROLLS (WATTLES)** SHALL BE PLACED AT THE DOWN SLOPE PERIMETER OF DISTURBANCE LIMITS TO PREVENT OR LIMIT SEDIMENT FROM LEAVING THE SITE. IN URBAN AREAS OR SITES DIRECTLY ADJACENT TO STREETS, FIBER ROLLS SHALL BE PLACED AT THE BACK OF SIDEWALK OR CURB TO LIMIT SEDIMENT FROM ENTERING THE STREET.
 - STORM DRAIN INLET PROTECTION:**
ALL STORM DRAIN INLETS ON THE SITE (NEW AND EXISTING) AND EXISTING DOWNSTREAM OFFSITE INLETS SHALL RECEIVE STORM DRAIN INLET PROTECTION AS SHOWN ON THE STORM DRAIN INLET PROTECT DETAIL ON THIS PLAN.
3. **STABILIZED CONSTRUCTION EXIT:**
THIS DESIGNER DOES NOT BELIEVE THAT A STABILIZED CONSTRUCTION EXIT WOULD BE EFFECTIVE FOR THIS PROJECT. CONTRACTOR SHALL EFFECTIVELY LIMIT OFF SITE TRACKING BY SWEEPING THE STREET DAILY IF NECESSARY AND BY OTHER MEANS AS DEVISED BY THE CONTRACTOR OR DIRECTED BY THE COUNTY INSPECTOR.
4. **ROCKED ACCESS AREAS:**
CONTRACTOR SHALL PROVIDE A ROCKED ACCESS AREA WERE CONSTRUCTION VEHICLES PARK, TRAVEL AND WORK. ROCKED ACCESS AREAS SHALL CONSIST OF 6" OF COMPACTED BASE ROCK OR DRAIN ROCK. ROCKED ACCESS AREAS ARE INTENDED TO KEEP CONSTRUCTION VEHICLES OFF OF BARE SOIL.
5. **HOUSE KEEPING REQUIREMENTS:**
 - DUST CONTROL /WIND EROSION CONTROL:**
CONTRACTOR SHALL EFFECTIVELY LIMIT DUST AND WIND EROSION BY WATERING THE SITE AS NEEDED AND KEEPING ALL MATERIAL STOCK PILES COVERED WHEN NOT IN USE.
 - CONSTRUCTION MATERIALS:**
ALL LOOSE OF STOCKPILED CONSTRUCTION MATERIALS THAT ARE NOT ACTIVELY BEING USED (I.E. SOIL SPOILS, AGGREGATE FLY ASH, STUCCO, HYDRATED LIME, ETC) SHALL BE COVERED AND BERMED.
ALL CHEMICALS SHALL BE STORED IN WATERTIGHT CONTAINERS (WITH APPROPRIATE SECONDARY CONTAINMENT TO PREVENT ANY SPILLAGE OR LEAKAGE) OR IN A STORAGE SHED, COMPLETELY ENCLOSED.
EXPOSURE OF CONSTRUCTION MATERIALS TO PRECIPITATION SHALL BE MINIMIZED. THIS DOES NOT INCLUDE THOSE MATERIALS AND EQUIPMENT THAT ARE INTENDED TO BE OUTSIDE.
BEST MANAGEMENT PRACTICES TO LIMIT AND PREVENT THE OFF-SITE TRACKING OF LOOSE CONSTRUCTION MATERIALS SHALL BE IMPLEMENTED.
 - WASTE MANAGEMENT:**
DISPOSAL OF ANY RINSE OR WASH WATER OR MATERIALS ON IMPERVIOUS OR PERVIOUS SURFACES OR INTO THE STORM DRAIN SYSTEM SHALL BE PREVENTED.
SANITATION FACILITIES SHALL BE CONTAINED (E.G. PORTABLE TOILETS) TO PREVENT DISCHARGES OF POLLUTANTS. PORTABLE TOILETS SHALL BE LOCATED A MINIMUM OF 20' FROM DRAIN INLETS, STREETS, DRIVEWAYS, DRAINAGE FACILITIES, STREAMS OR OTHER RIPARIAN AREAS.
SANITATION FACILITIES SHALL BE INSECTED REGULARLY AND CLEANED AND REPLACED AS NECESSARY.
COVER WASTE AND DISPOSAL CONTAINERS AT THE END OF EACH WORK DAY AND DURING EACH RAIN EVENT.
DISCHARGES FROM WASTE DISPOSAL CONTAINERS TO THE STORM WATER DRAINAGE SYSTEM SHALL BE PREVENTED.
STOCKPILED WASTE MATERIAL SHALL BE CONTAINED AND SECURELY PROTECTED FROM WIND AND RAIN AT ALL TIMES UNLESS ACTIVELY BEING USED.
PROCEDURES THAT EFFECTIVELY ADDRESS HAZARDOUS AND NON-HAZARDOUS SPILLS SHALL BE IMPLEMENTED.
EQUIPMENT AND MATERIALS FOR CLEANUP OF SPILLS SHALL BE AVAILABLE ON SITE SO THAT SPILLS AND LEAKS CAN AND SHALL BE CLEANED IMMEDIATELY AND DISPOSED OF PROPERLY.
CONCRETE WASHOUT AREAS AND OTHER WASHOUT AREAS THAT CONTAIN POSSIBLE POLLUTANTS SHALL BE CONSTRUCTED TO EFFECTIVELY CONTAIN POLLUTANTS SO THAT THERE IS NO DISCHARGE INTO THE SOIL OR SURROUNDING AREA.
6. **VEHICLE STORAGE & MAINTENANCE:**
MEASURES SHALL BE TAKEN TO PREVENT OIL, GREASE OR FUEL FROM LEAKING ONTO THE GROUND OR INTO STORM DRAINS OR SURFACE WATERS.
ALL EQUIPMENT OR VEHICLES, WHICH ARE TO BE FUELED, MAINTAINED AND STORED ON SITE SHALL BE IN A DESIGNATED AREA FITTED WITH APPROPRIATE BMP'S.
LEAKS SHALL BE IMMEDIATELY CLEANED AND LEAKED MATERIALS SHALL BE DISPOSED OF PROPERLY.
7. **LANDSCAPE MATERIALS:**
CONTAIN STOCKPILED AND STORED MATERIALS SUCH AS MULCHES, TOPSOIL, FERTILIZERS AND OTHER LANDSCAPE MATERIALS WHEN THEY ARE NOT BEING ACTIVELY USED.
DISCONTINUE THE APPLICATION OF ANY ERODIBLE LANDSCAPE MATERIALS WITHIN 2 DAYS BEFORE A FORECAST RAIN EVENT OR DURING PERIODS OF RAIN.
APPLY ERODIBLE LANDSCAPE MATERIAL AT QUANTITIES AND APPLICATION RATES ACCORDING TO MANUFACTURERS' RECOMMENDATIONS OR BASED ON WRITTEN SPECIFICATIONS BY KNOWLEDGEABLE AND EXPERIENCED PERSONNEL.


FOR REDUCED PLANS ORIGINAL SCALE IN INCHES

SHEET NAME: DRAWING NAME:

BY	
REVISION	
DATE	
PROJECT ENGINEER	MFG Engineers, Inc PO BOX 1914 APTOS, CA. 95001 (831) 763-1661 CEL (831) 601-9519
APN 057-011-111-34	
WATER CONTROL POLLUTION PLAN	
52 W. SUMMIT DRIVE, REDWOOD CITY, CA	
DRAWN:	MFG
CHECKED:	MFG
DATE:	4/22
SCALE:	1"=10'
JOB NO.	
SHEET	C3 OF 5

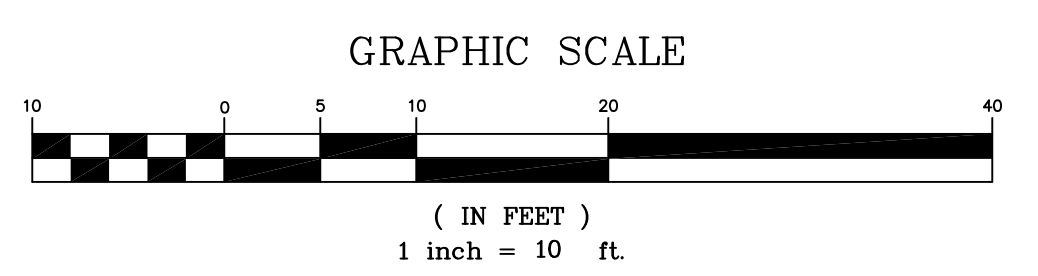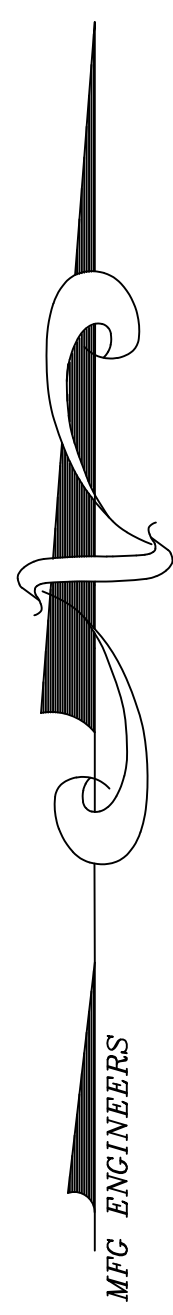


- EXISTING FEATURE NOTES
- 1 2' HIGH WOOD RETAINING WALL
 - 2 ROCK RETAINING WALL
 - 3 CONCRETE RETAINING WALL

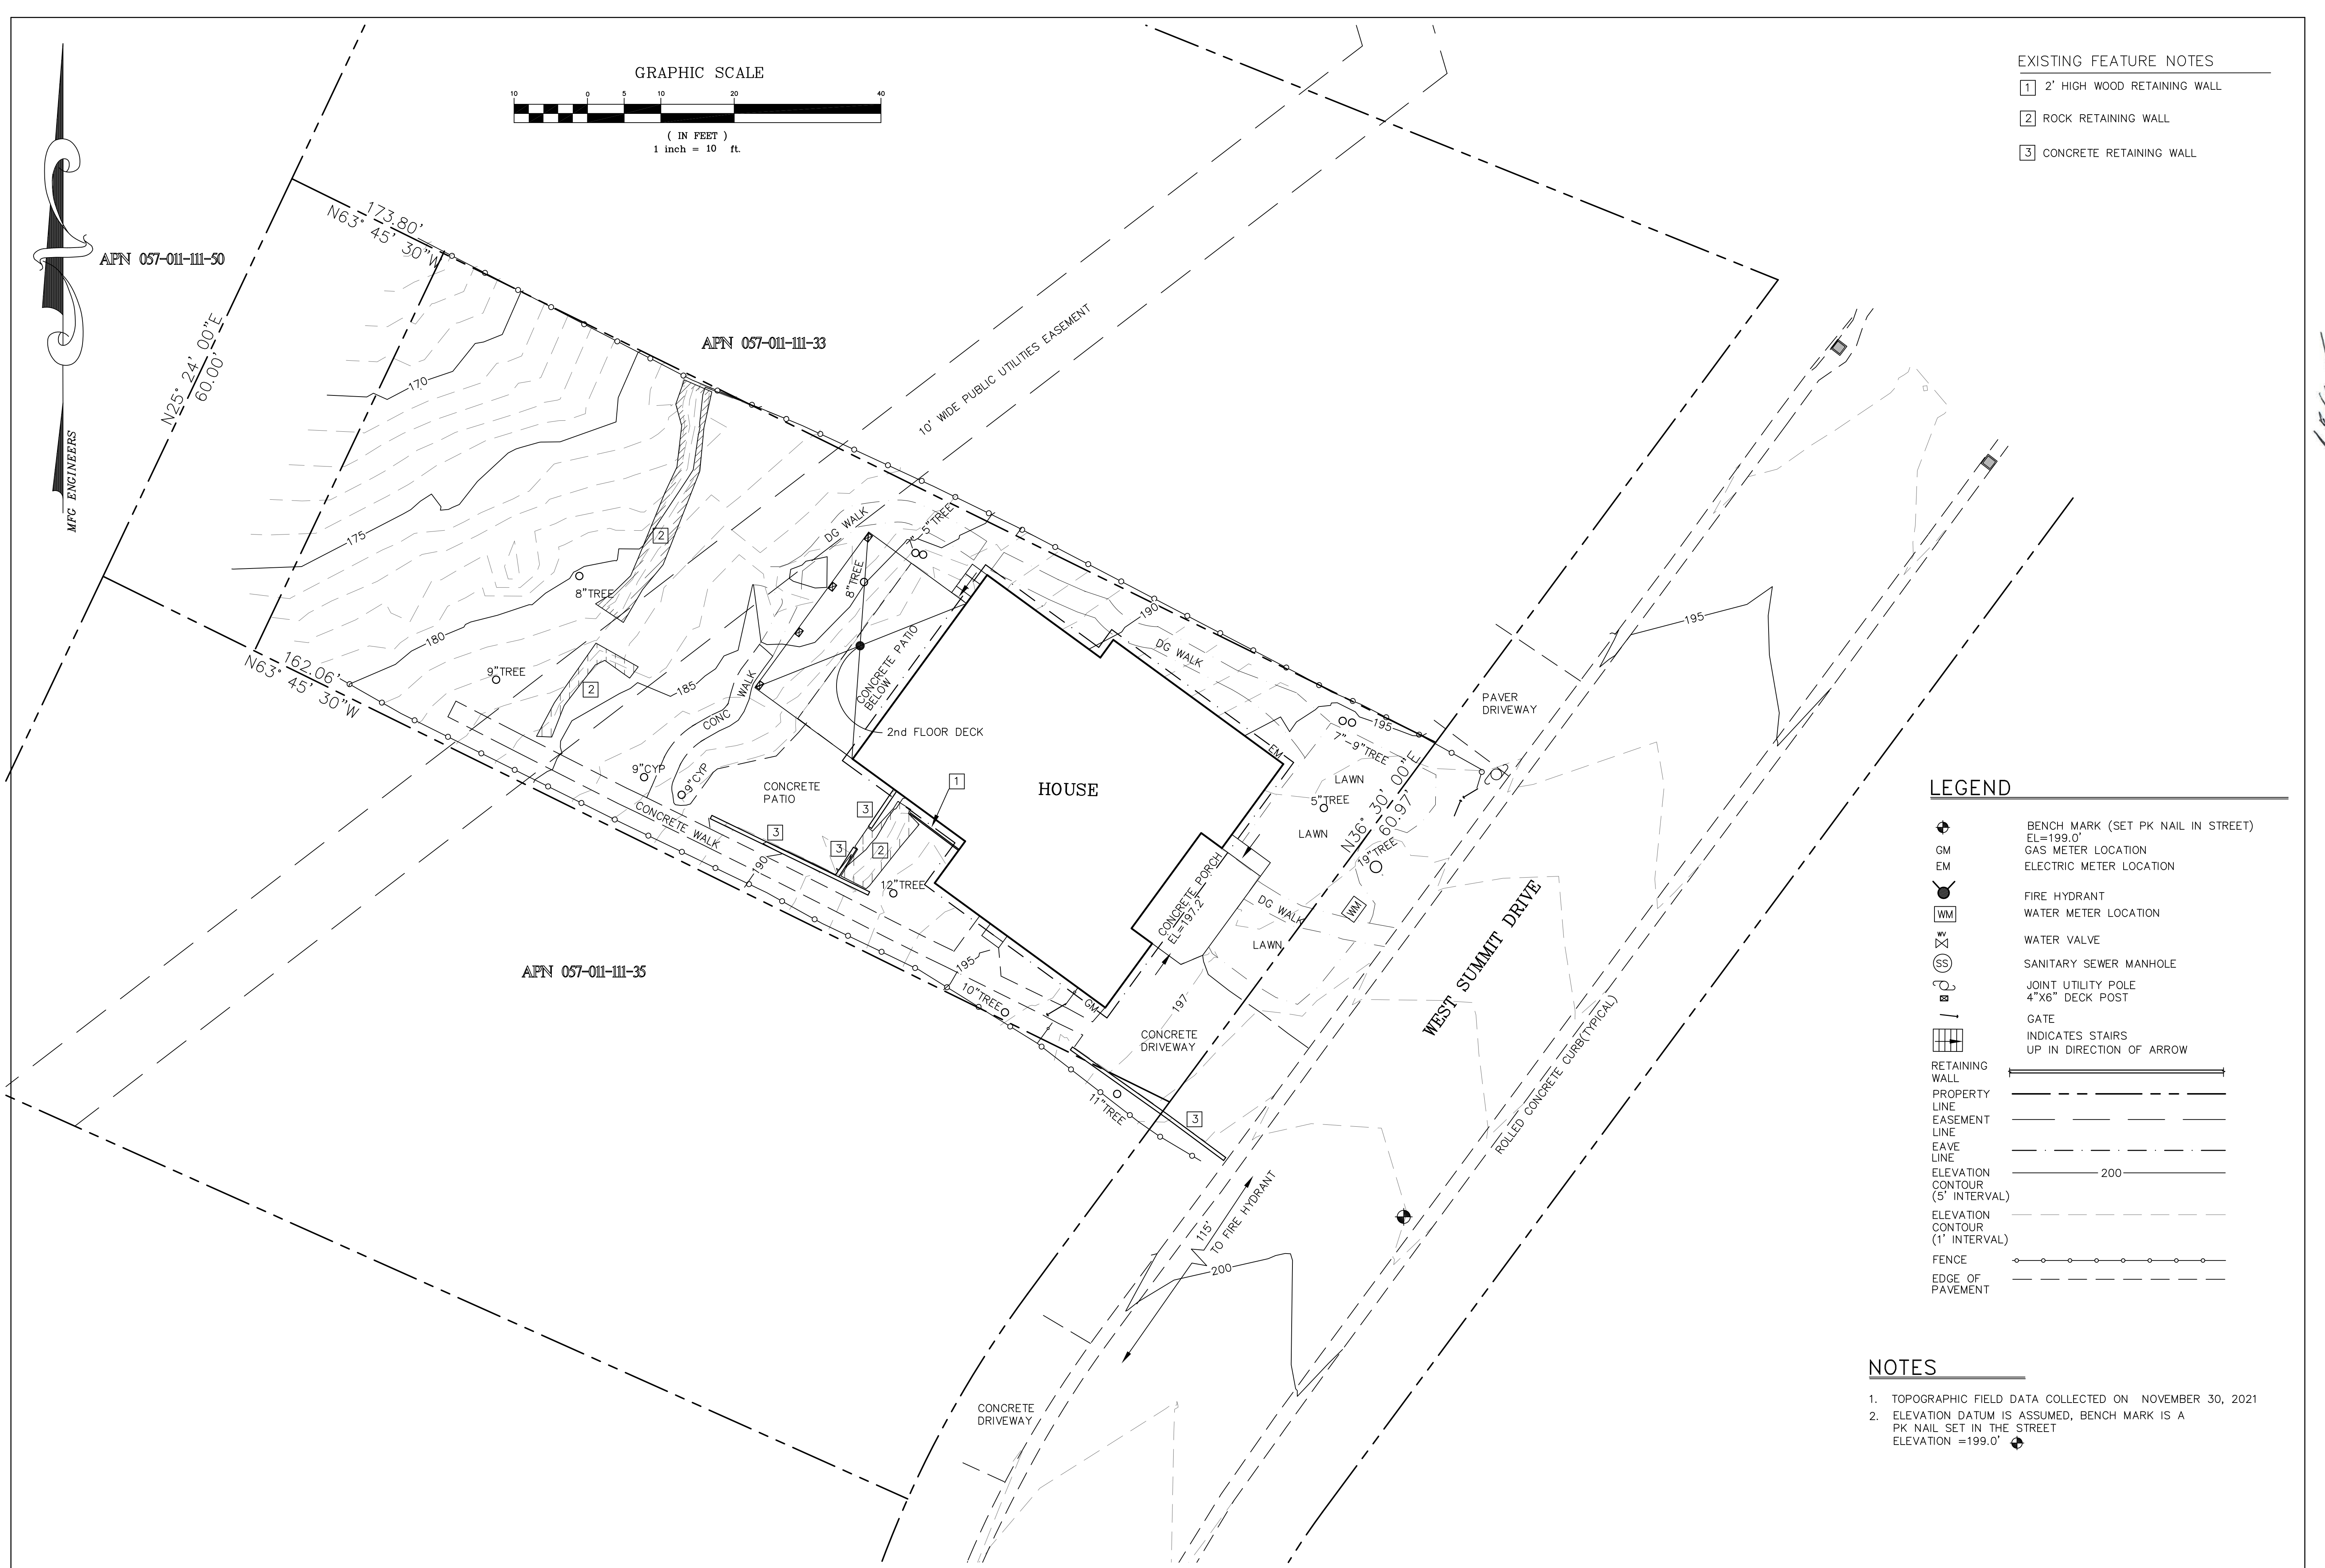

LEGEND


	BENCH MARK (SET PK NAIL IN STREET) EL=199.0'
GM	GAS METER LOCATION
EM	ELECTRIC METER LOCATION
	FIRE HYDRANT
	WATER METER LOCATION
	WATER VALVE
	SANITARY SEWER MANHOLE
	JOINT UTILITY POLE 4"x6" DECK POST
	GATE
	INDICATES STAIRS UP IN DIRECTION OF ARROW
	RETAINING WALL
	PROPERTY LINE
	EASEMENT LINE
	EAVE LINE
	ELEVATION CONTOUR (5' INTERVAL)
	ELEVATION CONTOUR (1' INTERVAL)
	FENCE
	EDGE OF PAVEMENT

- NOTES**
- TOPOGRAPHIC FIELD DATA COLLECTED ON NOVEMBER 30, 2021
 - ELEVATION DATUM IS ASSUMED, BENCH MARK IS A PK NAIL SET IN THE STREET
ELEVATION =199.0'

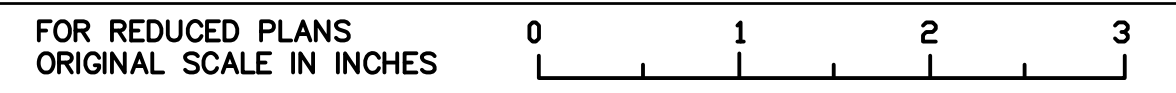

SHEET NAME: DRAWING NAME:

BY		REVISION		DATE	
PROJECT ENGINEER	MFC Engineers, Inc PO BOX 1914 APTOS, CA. 95001 (831) 763-1661 CEL (831) 601-9519				
APN 057-011-111-34	TOPOGRAPHIC MAP				
52 W. SUMMIT DRIVE, REDWOOD CITY, CA					
DRAWN: MFG					
CHECKED: MFG					
DATE: 12/21					
SCALE: 1"=10'					
JOB NO.					
SHEET					
C4 OF 5					

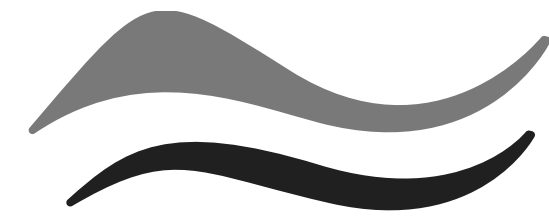

SAN MATEO COUNTYWIDE


Water Pollution Prevention Program

Clean Water. Healthy Community.

Construction Best Management Practices (BMPs)

Construction projects are required to implement the stormwater best management practices (BMP) on this page, as they apply to your project, all year long.


Painting & Paint Removal

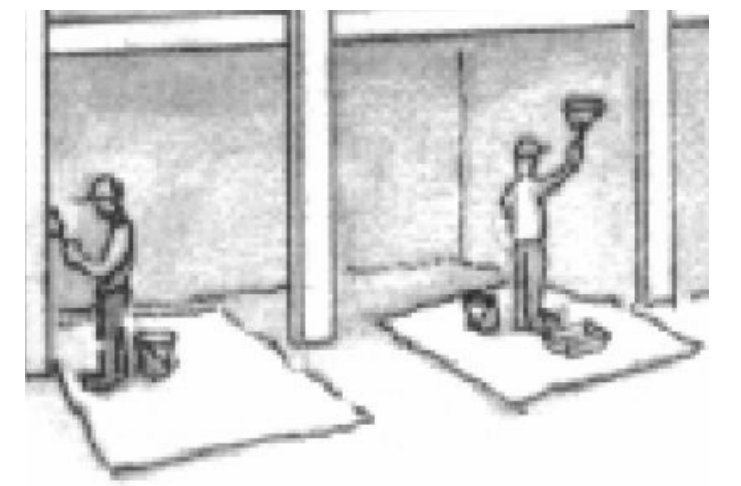

Painting Cleanup and Removal


- ❑ Never clean brushes or rinse paint containers into a street, gutter, storm drain, or stream.
- ❑ For water-based paints, paint out brushes to the extent possible, and rinse into a drain that goes to the sanitary sewer. Never pour paint down a storm drain.
- ❑ For oil-based paints, paint out brushes to the extent possible and clean with thinner or solvent in a proper container. Filter and reuse thinners and solvents. Dispose of excess liquids as hazardous waste.
- ❑ Paint chips and dust from non-hazardous dry stripping and sand blasting may be swept up or collected in plastic drop cloths and disposed of as trash.
- ❑ Chemical paint stripping residue and chips and dust from marine paints or paints containing lead, mercury, or tributyltin must be disposed of as hazardous waste. Lead based paint removal requires a state-certified contractor.

Dewatering

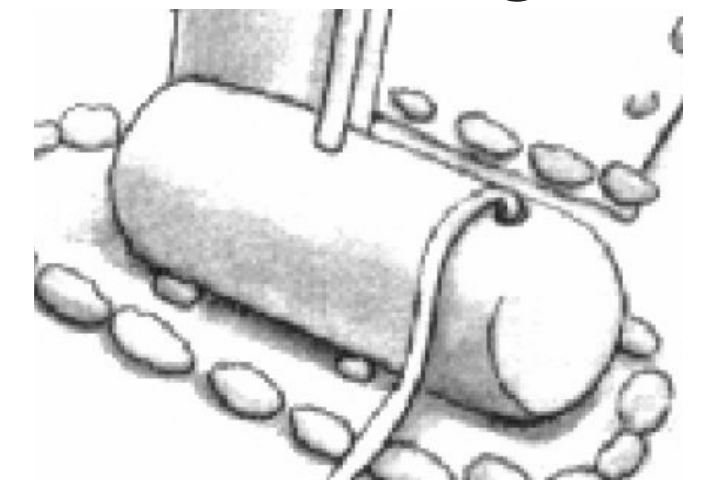

- ❑ Discharges of groundwater or captured runoff from dewatering operations must be properly managed and disposed. When possible send dewatering discharge to landscaped area or sanitary sewer. If discharging to the sanitary sewer call your local wastewater treatment plant.
- ❑ Divert run-on water from offsite away from all disturbed areas.
- ❑ When dewatering, notify and obtain approval from the local municipality before discharging water to a street gutter or storm drain. Filtration or diversion through a basin, tank, or sediment trap may be required.
- ❑ In areas of known or suspected contamination, call your local agency to determine whether the ground water must be tested. Pumped groundwater may need to be collected and hauled off-site for treatment and proper disposal.

Materials & Waste Management

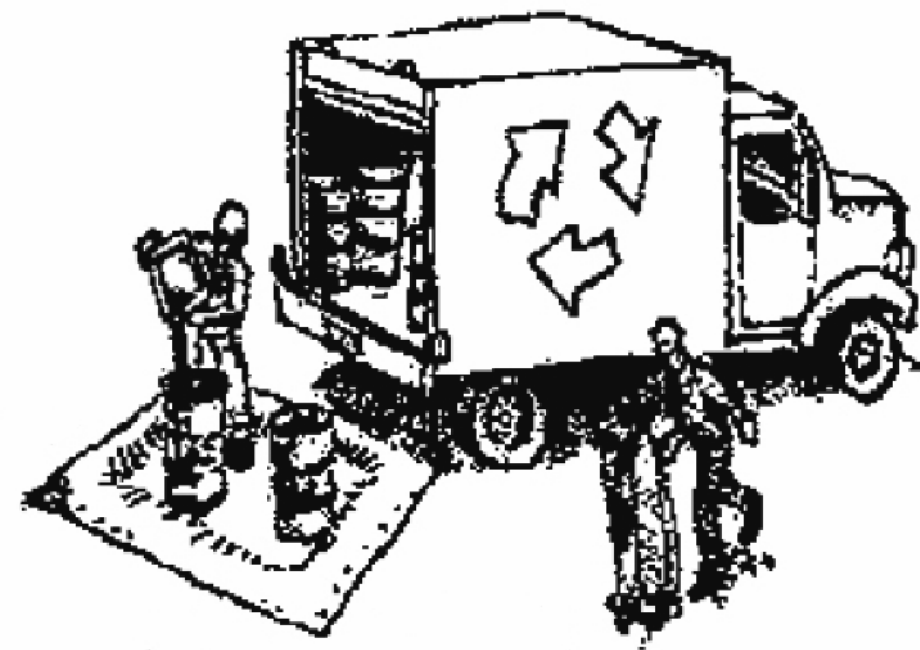

Non-Hazardous Materials

- ❑ Berm and cover stockpiles of sand, dirt or other construction material with tarps when rain is forecast or if not actively being used within 14 days.
- ❑ Use (but don't overuse) reclaimed water for dust control.

Hazardous Materials

- ❑ Label all hazardous materials and hazardous wastes (such as pesticides, paints, thinners, solvents, fuel, oil, and antifreeze) in accordance with city, county, state and federal regulations.
- ❑ Store hazardous materials and wastes in water tight containers, store in appropriate secondary containment, and cover them at the end of every work day or during wet weather or when rain is forecast.
- ❑ Follow manufacturer's application instructions for hazardous materials and be careful not to use more than necessary. Do not apply chemicals outdoors when rain is forecast within 24 hours.
- ❑ Arrange for appropriate disposal of all hazardous wastes.

Waste Management

- ❑ Cover waste disposal containers securely with tarps at the end of every work day and during wet weather.
- ❑ Check waste disposal containers frequently for leaks and to make sure they are not overfilled. Never hose down a dumpster on the construction site.
- ❑ Clean or replace portable toilets, and inspect them frequently for leaks and spills.
- ❑ Dispose of all wastes and debris properly. Recycle materials and wastes that can be recycled (such as asphalt, concrete, aggregate base materials, wood, gyp board, pipe, etc.)
- ❑ Dispose of liquid residues from paints, thinners, solvents, glues, and cleaning fluids as hazardous waste.

Construction Entrances and Perimeter

- ❑ Establish and maintain effective perimeter controls and stabilize all construction entrances and exits to sufficiently control erosion and sediment discharges from site and tracking off site.
- ❑ Sweep or vacuum any street tracking immediately and secure sediment source to prevent further tracking. Never hose down streets to clean up tracking.

Equipment Management & Spill Control




Maintenance and Parking

- ❑ Designate an area, fitted with appropriate BMPs, for vehicle and equipment parking and storage.
- ❑ Perform major maintenance, repair jobs, and vehicle and equipment washing off site.
- ❑ If refueling or vehicle maintenance must be done onsite, work in a bermed area away from storm drains and over a drip pan or drop cloths big enough to collect fluids. Recycle or dispose of fluids as hazardous waste.
- ❑ If vehicle or equipment cleaning must be done onsite, clean with water only in a bermed area that will not allow rinse water to run into gutters, streets, storm drains, or surface waters.
- ❑ Do not clean vehicle or equipment onsite using soaps, solvents, degreasers, or steam cleaning equipment.

Spill Prevention and Control

- ❑ Keep spill cleanup materials (e.g., rags, absorbents and cat litter) available at the construction site at all times.
- ❑ Inspect vehicles and equipment frequently for and repair leaks promptly. Use drip pans to catch leaks until repairs are made.
- ❑ Clean up spills or leaks immediately and dispose of cleanup materials properly.
- ❑ Do not hose down surfaces where fluids have spilled. Use dry cleanup methods (absorbent materials, cat litter, and/or rags).
- ❑ Sweep up spilled dry materials immediately. Do not try to wash them away with water, or bury them.
- ❑ Clean up spills on dirt areas by digging up and properly disposing of contaminated soil.
- ❑ Report significant spills immediately. You are required by law to report all significant releases of hazardous materials, including oil. To report a spill: 1) Dial 911 or your local emergency response number, 2) Call the Governor's Office of Emergency Services Warning Center, (800) 852-7550 (24 hours).

Earthmoving

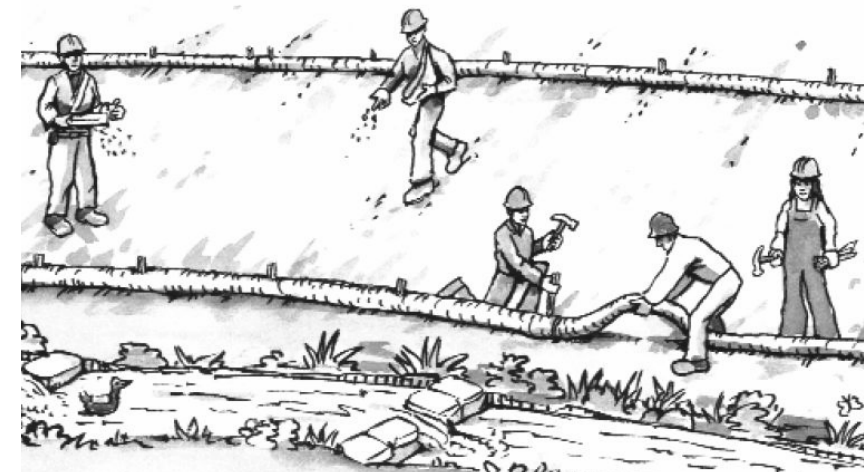

- ❑ Schedule grading and excavation work during dry weather.
- ❑ Stabilize all denuded areas, install and maintain temporary erosion controls (such as erosion control fabric or bonded fiber matrix) until vegetation is established.
- ❑ Remove existing vegetation only when absolutely necessary, and seed or plant vegetation for erosion control on slopes or where construction is not immediately planned.
- ❑ Prevent sediment from migrating offsite and protect storm drain inlets, gutters, ditches, and drainage courses by installing and maintaining appropriate BMPs, such as fiber rolls, silt fences, sediment basins, gravel bags, berms, etc.
- ❑ Keep excavated soil on site and transfer it to dump trucks on site, not in the streets.

Contaminated Soils

- ❑ If any of the following conditions are observed, test for contamination and contact the Regional Water Quality Control Board:
 - Unusual soil conditions, discoloration, or odor.
 - Abandoned underground tanks.
 - Abandoned wells
 - Buried barrels, debris, or trash.

Paving/Asphalt Work



- ❑ Avoid paving and seal coating in wet weather or when rain is forecast, to prevent materials that have not cured from contacting stormwater runoff.
- ❑ Cover storm drain inlets and manholes when applying seal coat, tack coat, slurry seal, fog seal, etc.
- ❑ Collect and recycle or appropriately dispose of excess abrasive gravel or sand. Do NOT sweep or wash it into gutters.
- ❑ Do not use water to wash down fresh asphalt concrete pavement.

Sawcutting & Asphalt/Concrete Removal

- ❑ Protect nearby storm drain inlets when saw cutting. Use filter fabric, catch basin inlet filters, or gravel bags to keep slurry out of the storm drain system.
- ❑ Shovel, absorb, or vacuum saw-cut slurry and dispose of all waste as soon as you are finished in one location or at the end of each work day (whichever is sooner!).
- ❑ If sawcut slurry enters a catch basin, clean it up immediately.

Concrete, Grout & Mortar Application




- ❑ Store concrete, grout, and mortar away from storm drains or waterways, and on pallets under cover to protect them from rain, runoff, and wind.
- ❑ Wash out concrete equipment/trucks offsite or in a designated washout area, where the water will flow into a temporary waste pit, and in a manner that will prevent leaching into the underlying soil or onto surrounding areas. Let concrete harden and dispose of as garbage.
- ❑ When washing exposed aggregate, prevent washwater from entering storm drains. Block any inlets and vacuum gutters, hose washwater onto dirt areas, or drain onto a bermed surface to be pumped and disposed of properly.

Landscaping



- ❑ Protect stockpiled landscaping materials from wind and rain by storing them under tarps all year-round.
- ❑ Stack bagged material on pallets and under cover.
- ❑ Discontinue application of any erodible landscape material within 2 days before a forecast rain event or during wet weather.

Storm drain polluters may be liable for fines of up to \$10,000 per day!

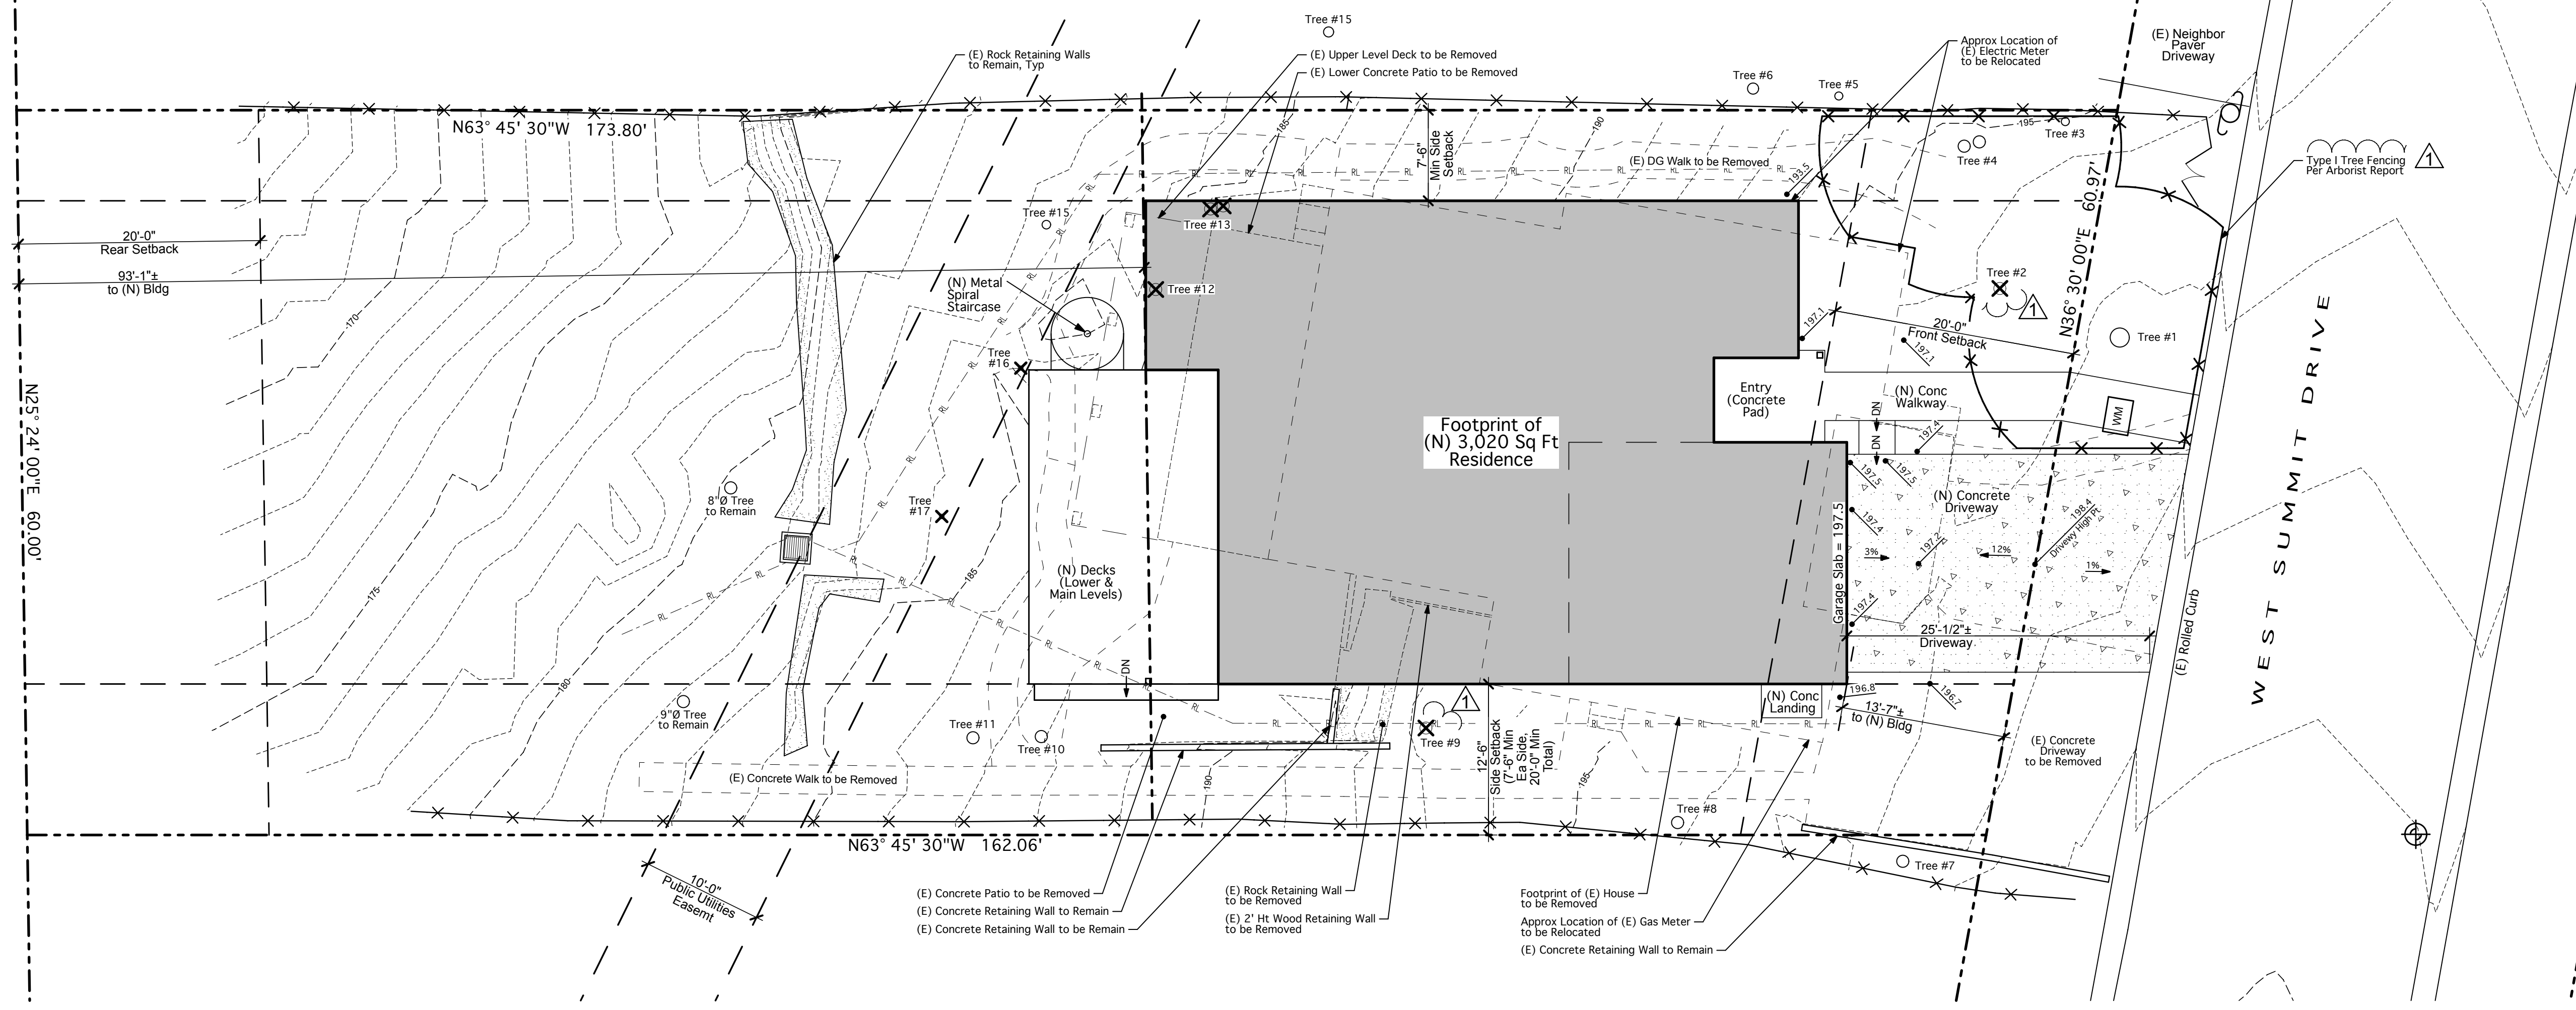

SCHEMATIC SITE PLAN

Prep Site for New Construction. Verify All Dimensions & Site Conditions in Field. Notify Architect of Discrepancies Immediately in Writing. Orientation of Plan Differs From Others in Set.
 NOTE: (E) Landscaping to Remain UON, <500 sf of Landscaping Proposed. Should Scope of Work Change, Provide MWLO Compliance per AHJ Reqmts.

APN: 057-111-34-0
 LOT SIZE: 10,076 Sq Ft
 ZONING: RH-DR (Residential Hillside / Design Review)

ALLOWABLE FAR: 3,022 Sq Ft @ 30%
 ALLOWABLE LOT COVERAGE: 2,519 Sq Ft @ 25%

Tree Survey

Tree#	Species	DBH	Ht/Sp	Con Rating	Comments	Status
1	Fern pine <i>Podocarpus gracilior</i>	19.3"	25/20	65	Good health and fair condition topped by utilities, Significant	To Remain
2	Crape myrtle <i>Lagerstroemia indica</i>	5.8"	12/6	40	Fair health, poor condition, split trunk, Not Significant	To Be Removed
3	Almond <i>Prunus dulcis</i>	8.0"	15/8	50	Fair health and condition, drought stressed, Not Significant	To Remain
4	Camphor <i>Cinnamomum camphor</i>	10.7"/7.2"	25/18	50	Fair health and condition, codominant at 2', drought stressed, Significant	To Remain
5	Fern pine <i>Podocarpus gracilior</i>	8"est	25/6	60	Fair health and condition, neighbor's tree, Not Significant	To Remain (Neighboring Property)
6	Coast live oak <i>Quercus agrifolia</i>	11"est	25/6	50	Fair health and condition, poorly pruned, neighbor's tree, Not Significant	To Remain (Neighboring Property)
7	Bradford pear <i>Pyrus calleryana</i>	11.9"	25/12	50	Fair health and poor condition, topped, fireblight, Not Significant	To Remain
8	Plum <i>Prunus cerasifera</i>	10.1"	25/8	50	Fair health and condition Not Significant	To Remain
9	Plum <i>Prunus cerasifera</i>	11.6"	12/8	20	Fair health, very poor condition, decayed and topped, Not Significant	To Be Removed
10	Italian cypress <i>Cypressus sempervirens</i>	10.3"	30/5	80	Good health and condition Not Significant	To Remain
11	Italian cypress <i>Cypressus sempervirens</i>	9.8"	28/3	80	Good health and condition Not Significant	To Remain
12	Guava <i>Psidium guajava</i>	9.7"	15/10	60	Fair health and condition, growing through deck, Not Significant	To Be Removed
13	Loquat <i>Eriobotrya japonica</i>	7.5"/4.2"	15/8	70	Good health and condition, codominant at grade, Not Significant	To Be Removed
14	Coast live oak <i>Quercus agrifolia</i>	10"est	25/6	50	Fair health and condition, poorly pruned, neighbor's tree, Not Significant	To Remain (Neighboring Property)
15	Plum <i>Prunus cerasifera</i>	8.6"	15/10	60	Fair health and condition, topped Not Significant	To Remain
16	Citrus <i>Citrus spp</i>	5.2"@grade	10/6	65	Fair health and condition Not Significant	To Be Removed
17	Plum <i>Prunus cerasifera</i>	5.3"/2.6"	10/6	60	Fair health and condition, topped Not Significant	To Remain

1615 Westwood Drive
 San Jose, CA 95125
 Phone: 408-209-5152
 terry@mar-arch.com

TERRY J. MARTIN ASSOCIATES, A.I.A.
 RESIDENTIAL & COMMERCIAL ARCHITECTURE
 License # 423221

Dates & Revisions	
Architectural Design Review Resubmittal	08/05/2022
Architectural Design Review Submittal	05/02/2022


Rev. Description: _____ Date: _____

Martin-Weiss Residence
 Custom Residence
 52 West Summit Drive
 Emerald Hills, CA 94062

Print Date: 08/05/2022
 Project: #21034
 Scale: 1/8" = 1'
 Drawn by: TJ, RTP

Sheet Title:
SCHEMATIC SITE PLAN



A-2

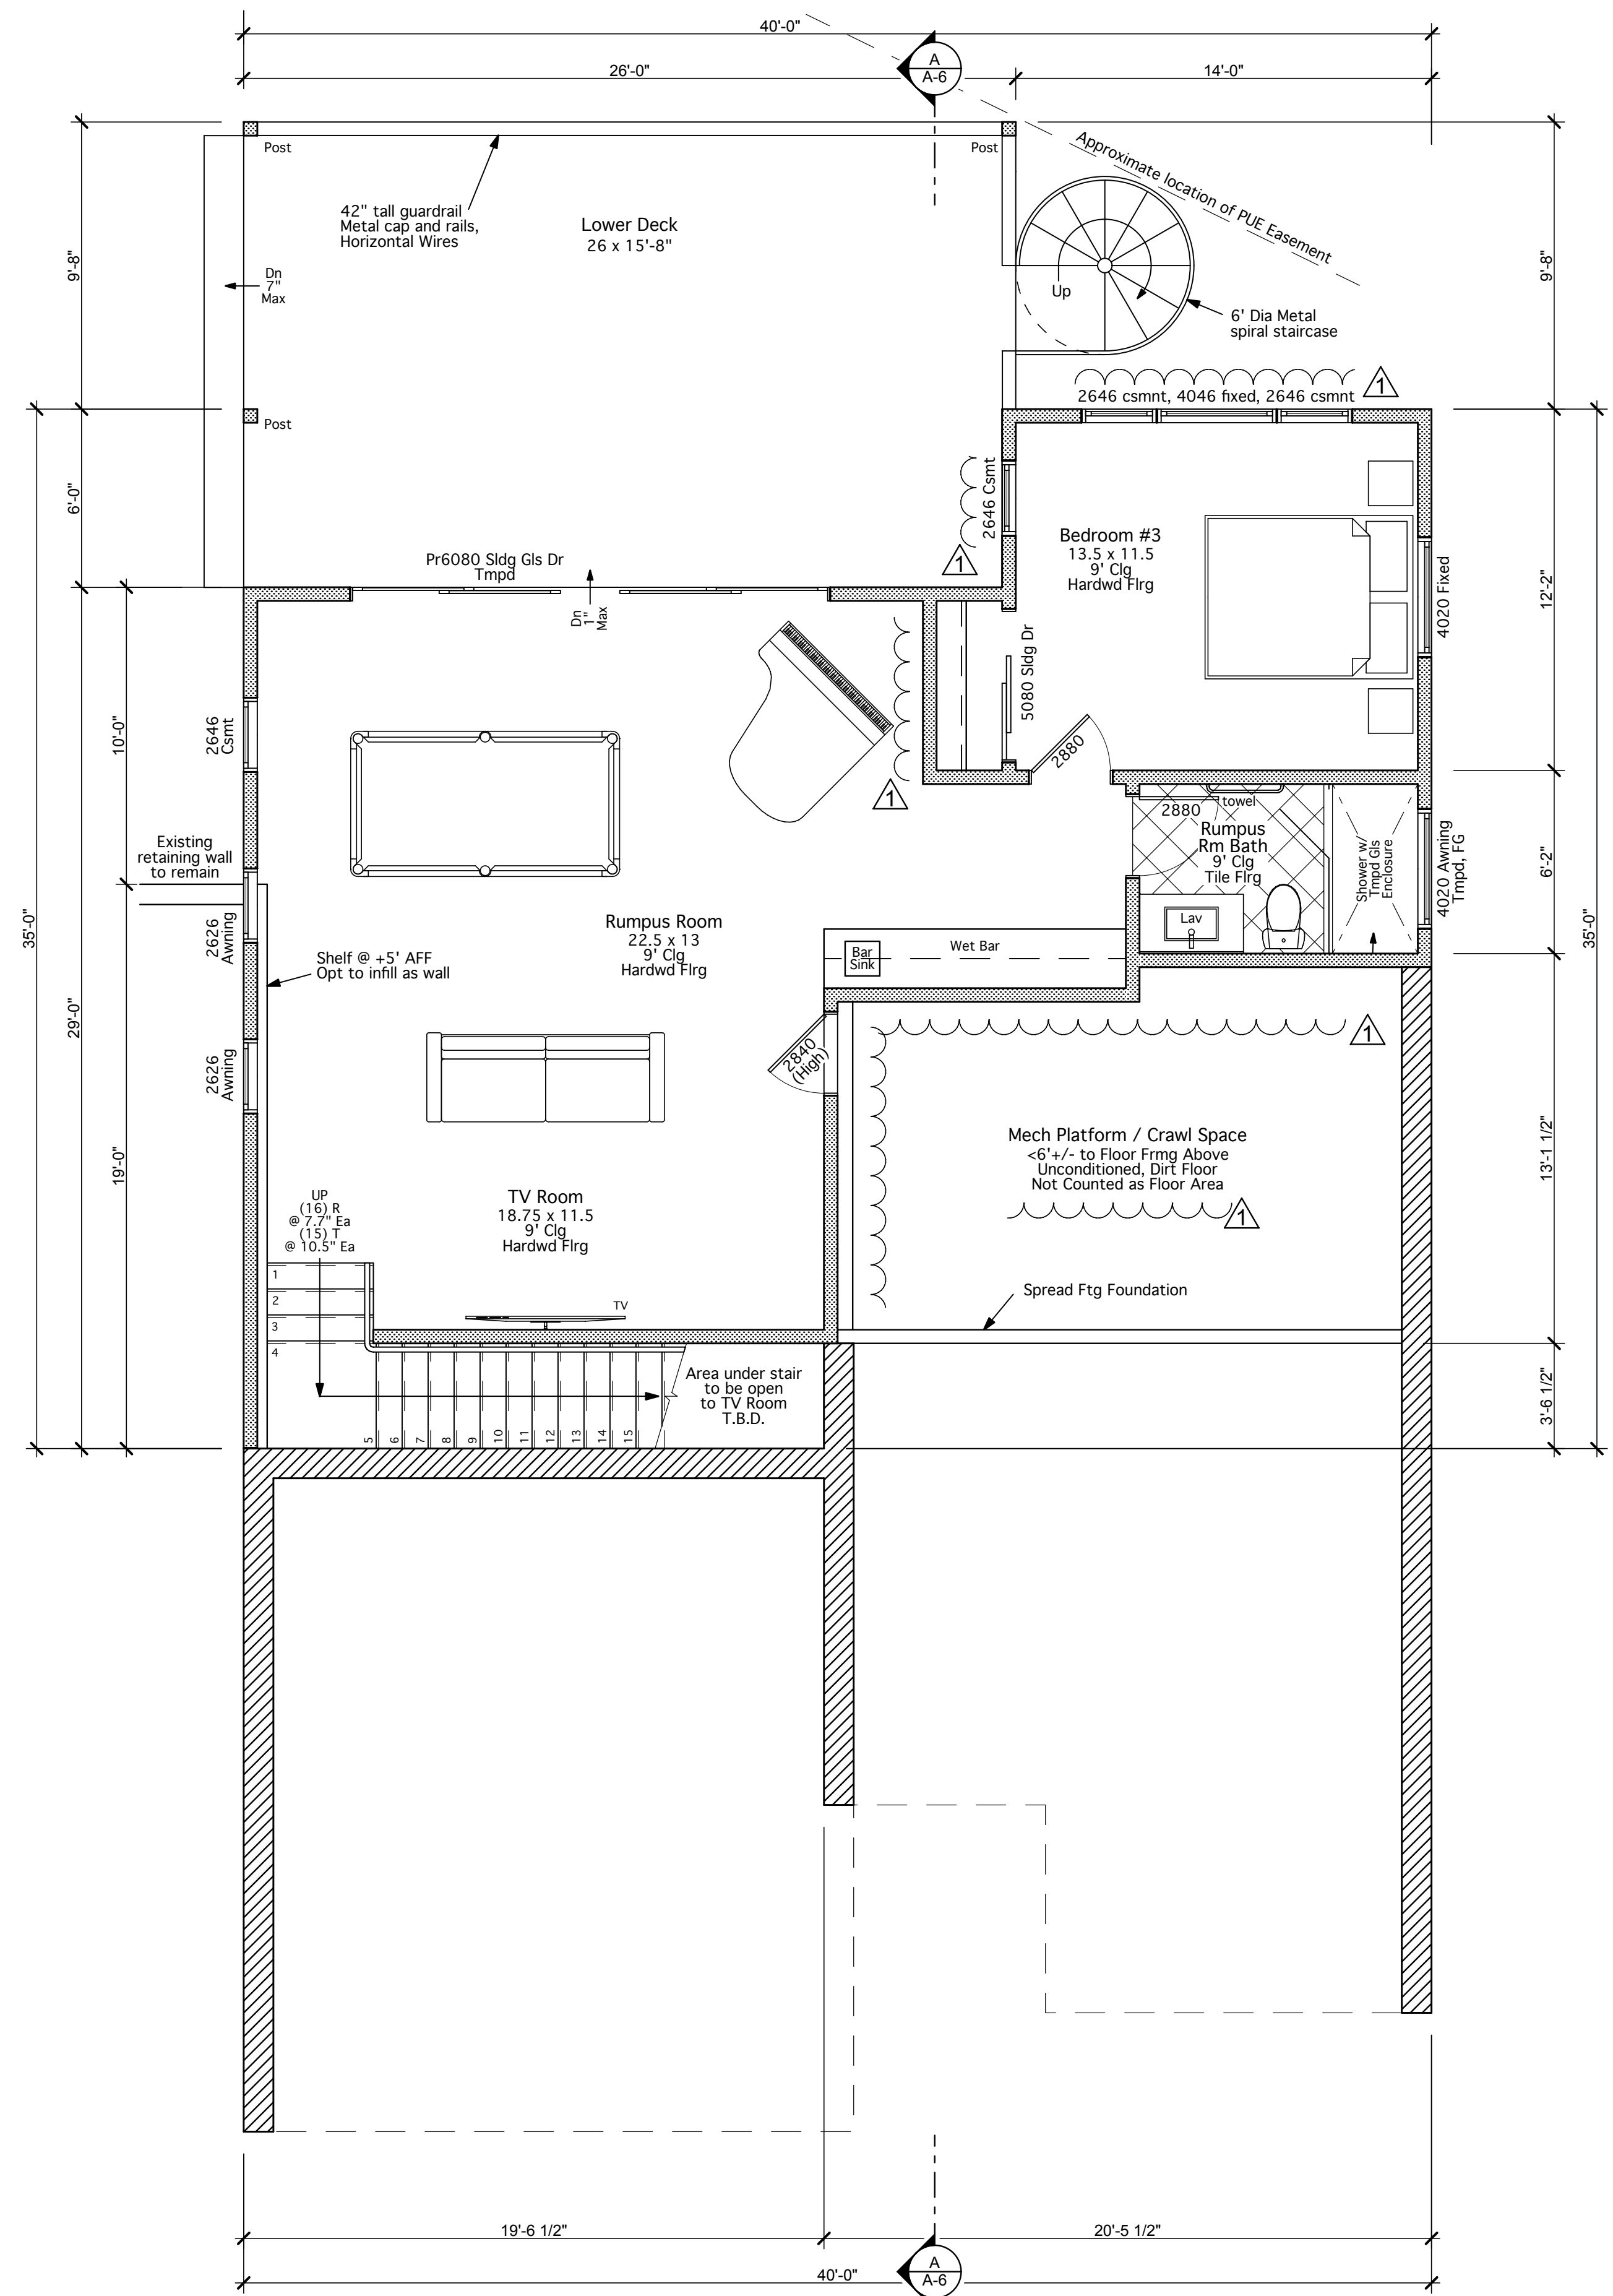

LOWER LEVEL FLOOR PLAN

See General Notes, Sheet A-1.1, SN For Additional Reqmts
 Field Verify All Dimensions & Conditions Prior to Commencing Work. Notify Architect of Discrepancies Immediately in Writing.
 All dimensions are to Face of Stud UON

Lower Level	933 Sq Ft
Main Level	1,585 Sq Ft
Total Living SF	2,518 Sq Ft
<small>Includes Stairs Open to Below</small>	
+ 2-Car Garage	453 Sq Ft
+ Entry	49 Sq Ft
Total Square Footage	3,020 Sq Ft
Total Allowable	3,022 Sq Ft @ 30%

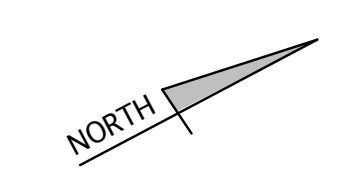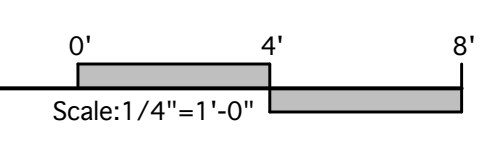

1615 Westwood Drive
 San Jose, CA 95125
 Phone: 408-209-5152
 terry@mar-arch.com

TERRY J. MARTIN ASSOCIATES, A.I.A.
 RESIDENTIAL & COMMERCIAL ARCHITECTURE
 License # 623221

Dates & Revisions	
Architectural Design Review Resubmittal	08/05/2022
Architectural Design Review Submittal	05/02/2022


Rev. Description

Martin-Weiss Residence
 Custom Residence
 52 West Summit Drive
 Emerald Hills, CA 94062

Print Date:	08/05/2022
Project:	#21034
Scale:	1/4" = 1'
Drawn by:	TJ, RTP

Sheet Title:
LOWER LEVEL FLOOR PLAN

A-3.1

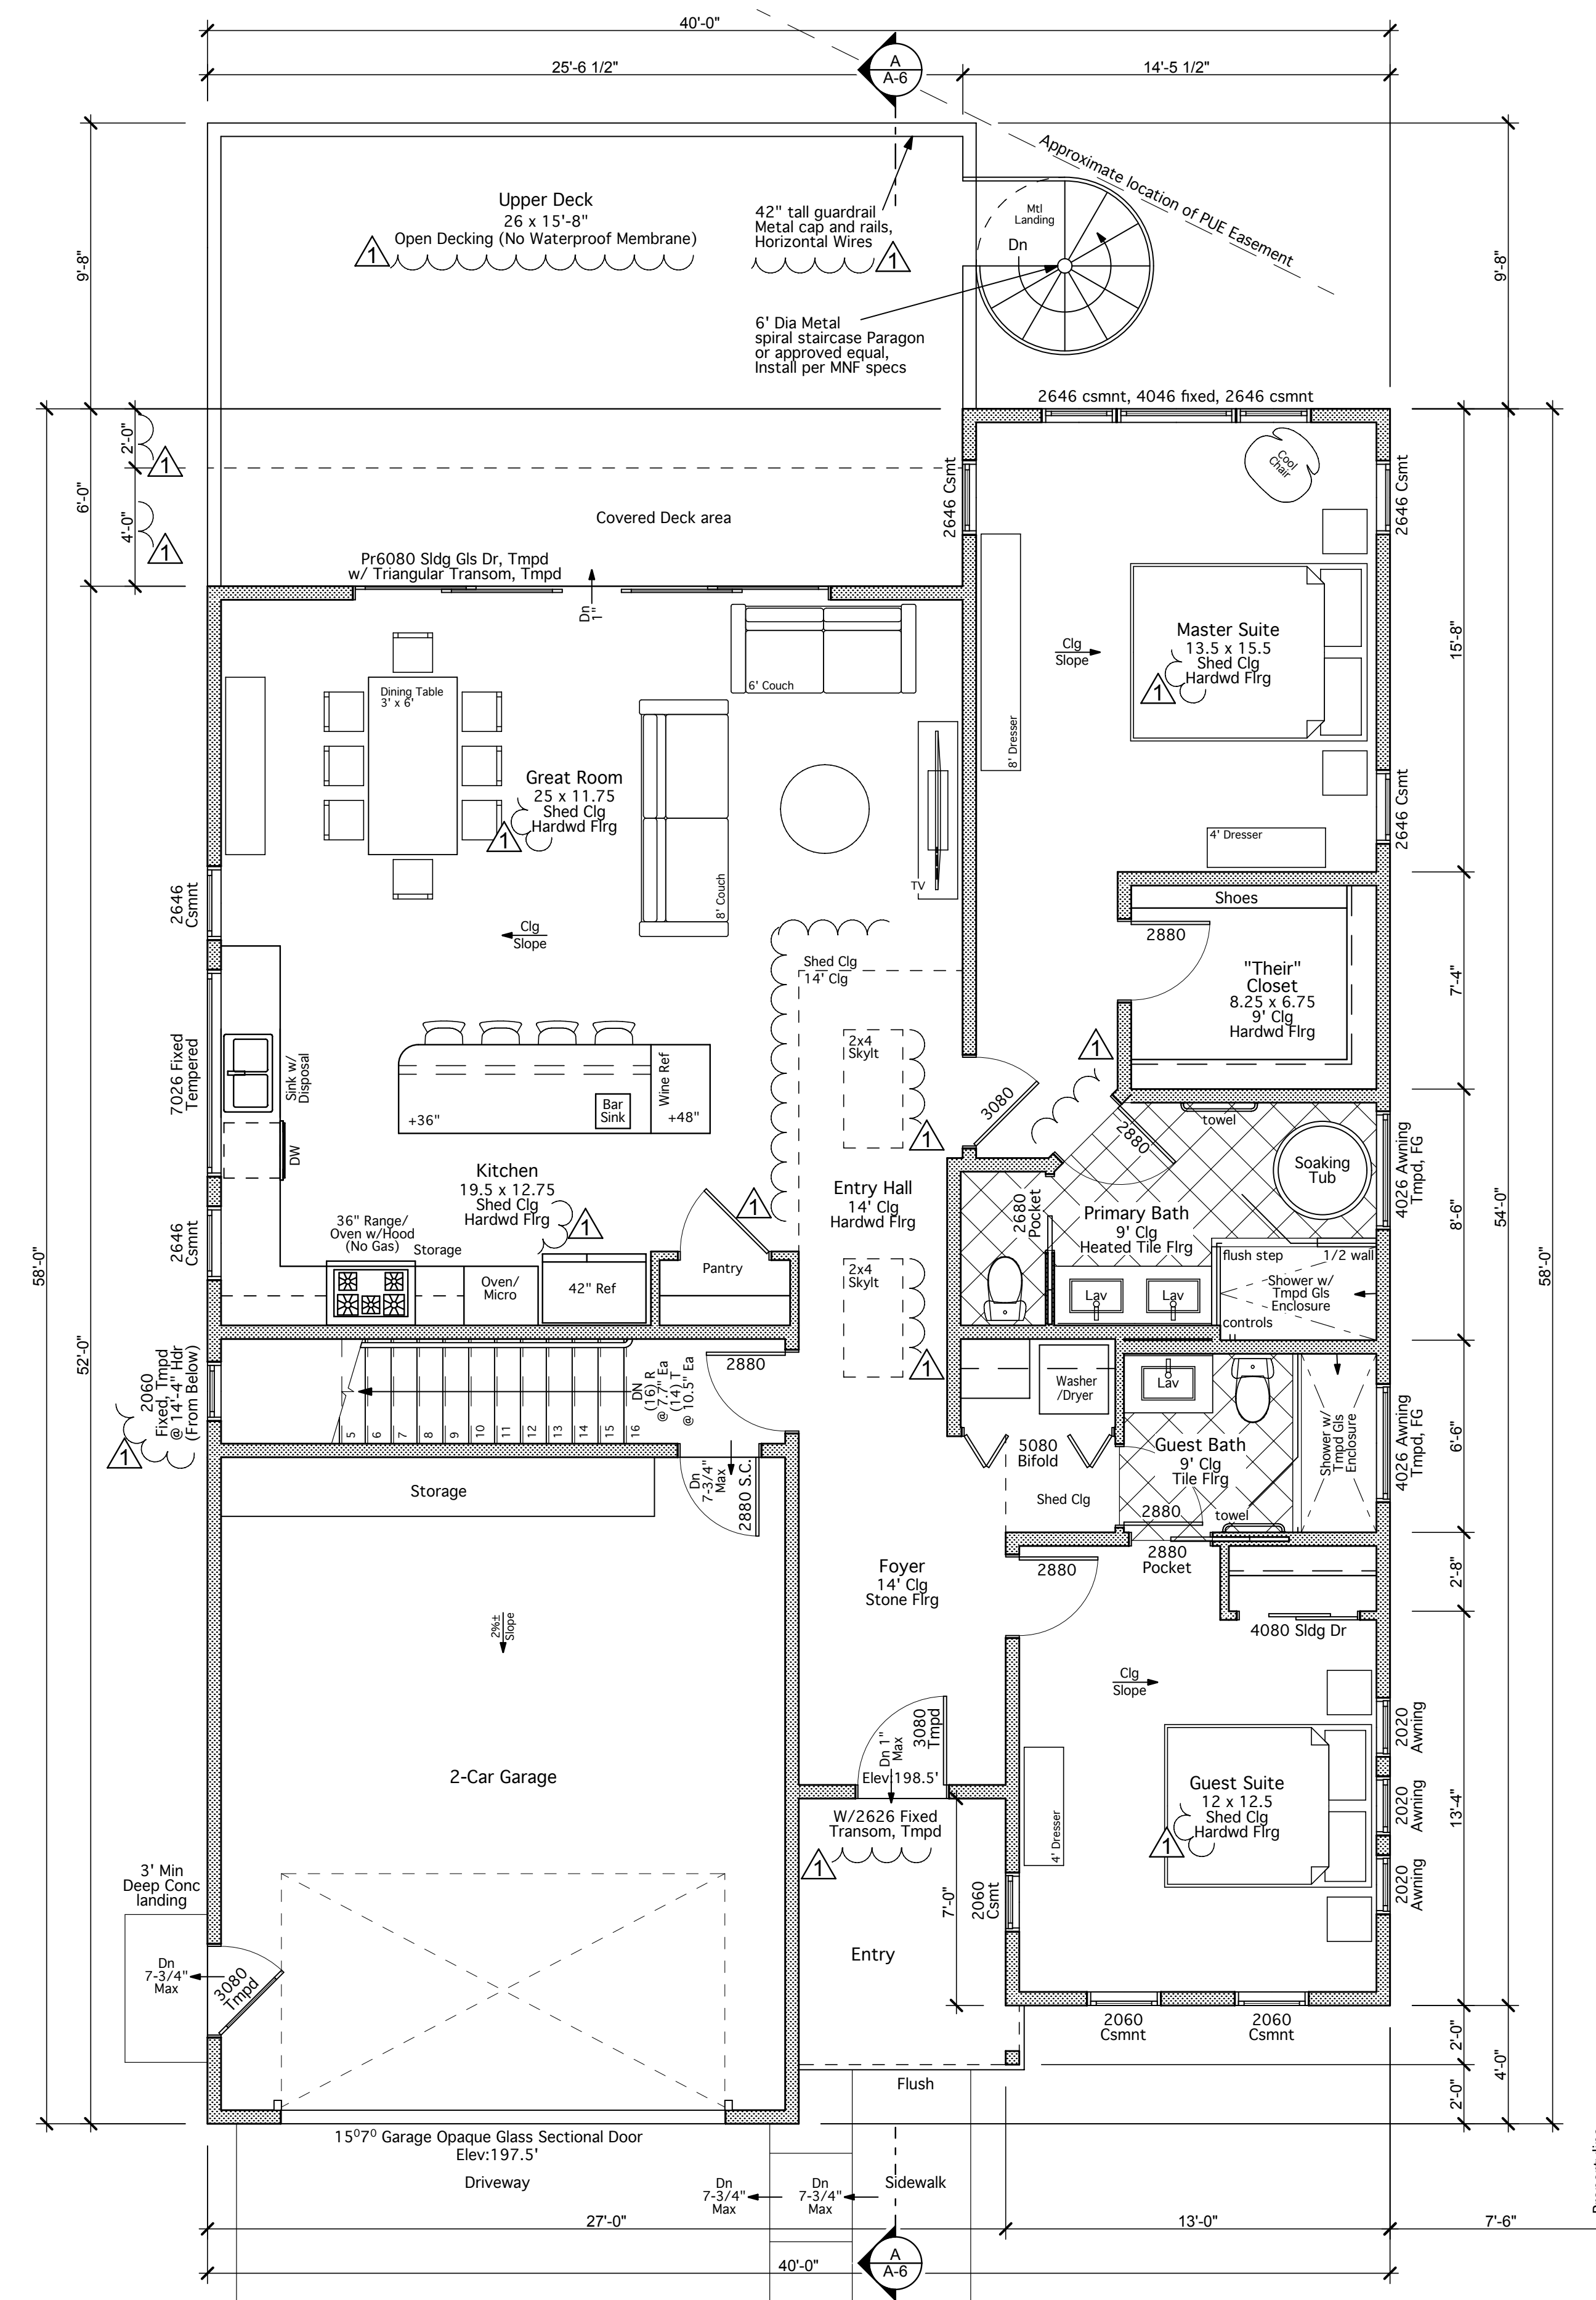

MAIN LEVEL FLOOR PLAN

See General Notes, Sheet A-1.1, SN For Additional Reqmts
 Field Verify All Dimensions & Conditions Prior to Commencing Work. Notify Architect of Discrepancies Immediately in Writing.
 All dimensions are to Face of Stud UON

Lower Level	933 Sq Ft
Main Level	1,585 Sq Ft
Total Living SF Includes Stairs Open to Below	2,518 Sq Ft
+ 2-Car Garage	453 Sq Ft
+ Entry	49 Sq Ft
Total Square Footage	3,020 Sq Ft
Total Allowable	3,022 Sq Ft @ 30%

1615 Westwood Drive
 San Jose, CA 95125
 Phone: 408-209-5152
 terry@mararch.com

TERRY J. MARTIN ASSOCIATES, A.I.A.
 RESIDENTIAL & COMMERCIAL ARCHITECTURE
 License # 623221

Dates & Revisions	
Architectural Design Review Resubmittal	08/05/2022
Architectural Design Review Submittal	05/02/2022


Rev. Description

Martin-Weiss Residence
 Custom Residence
 52 West Summit Drive
 Emerald Hills, CA 94062

Print Date:	08/05/2022
Project:	#21034
Scale:	1/4" = 1'
Drawn by:	TJ, RTP



Sheet Title:
MAIN LEVEL FLOOR PLAN

A-3.2

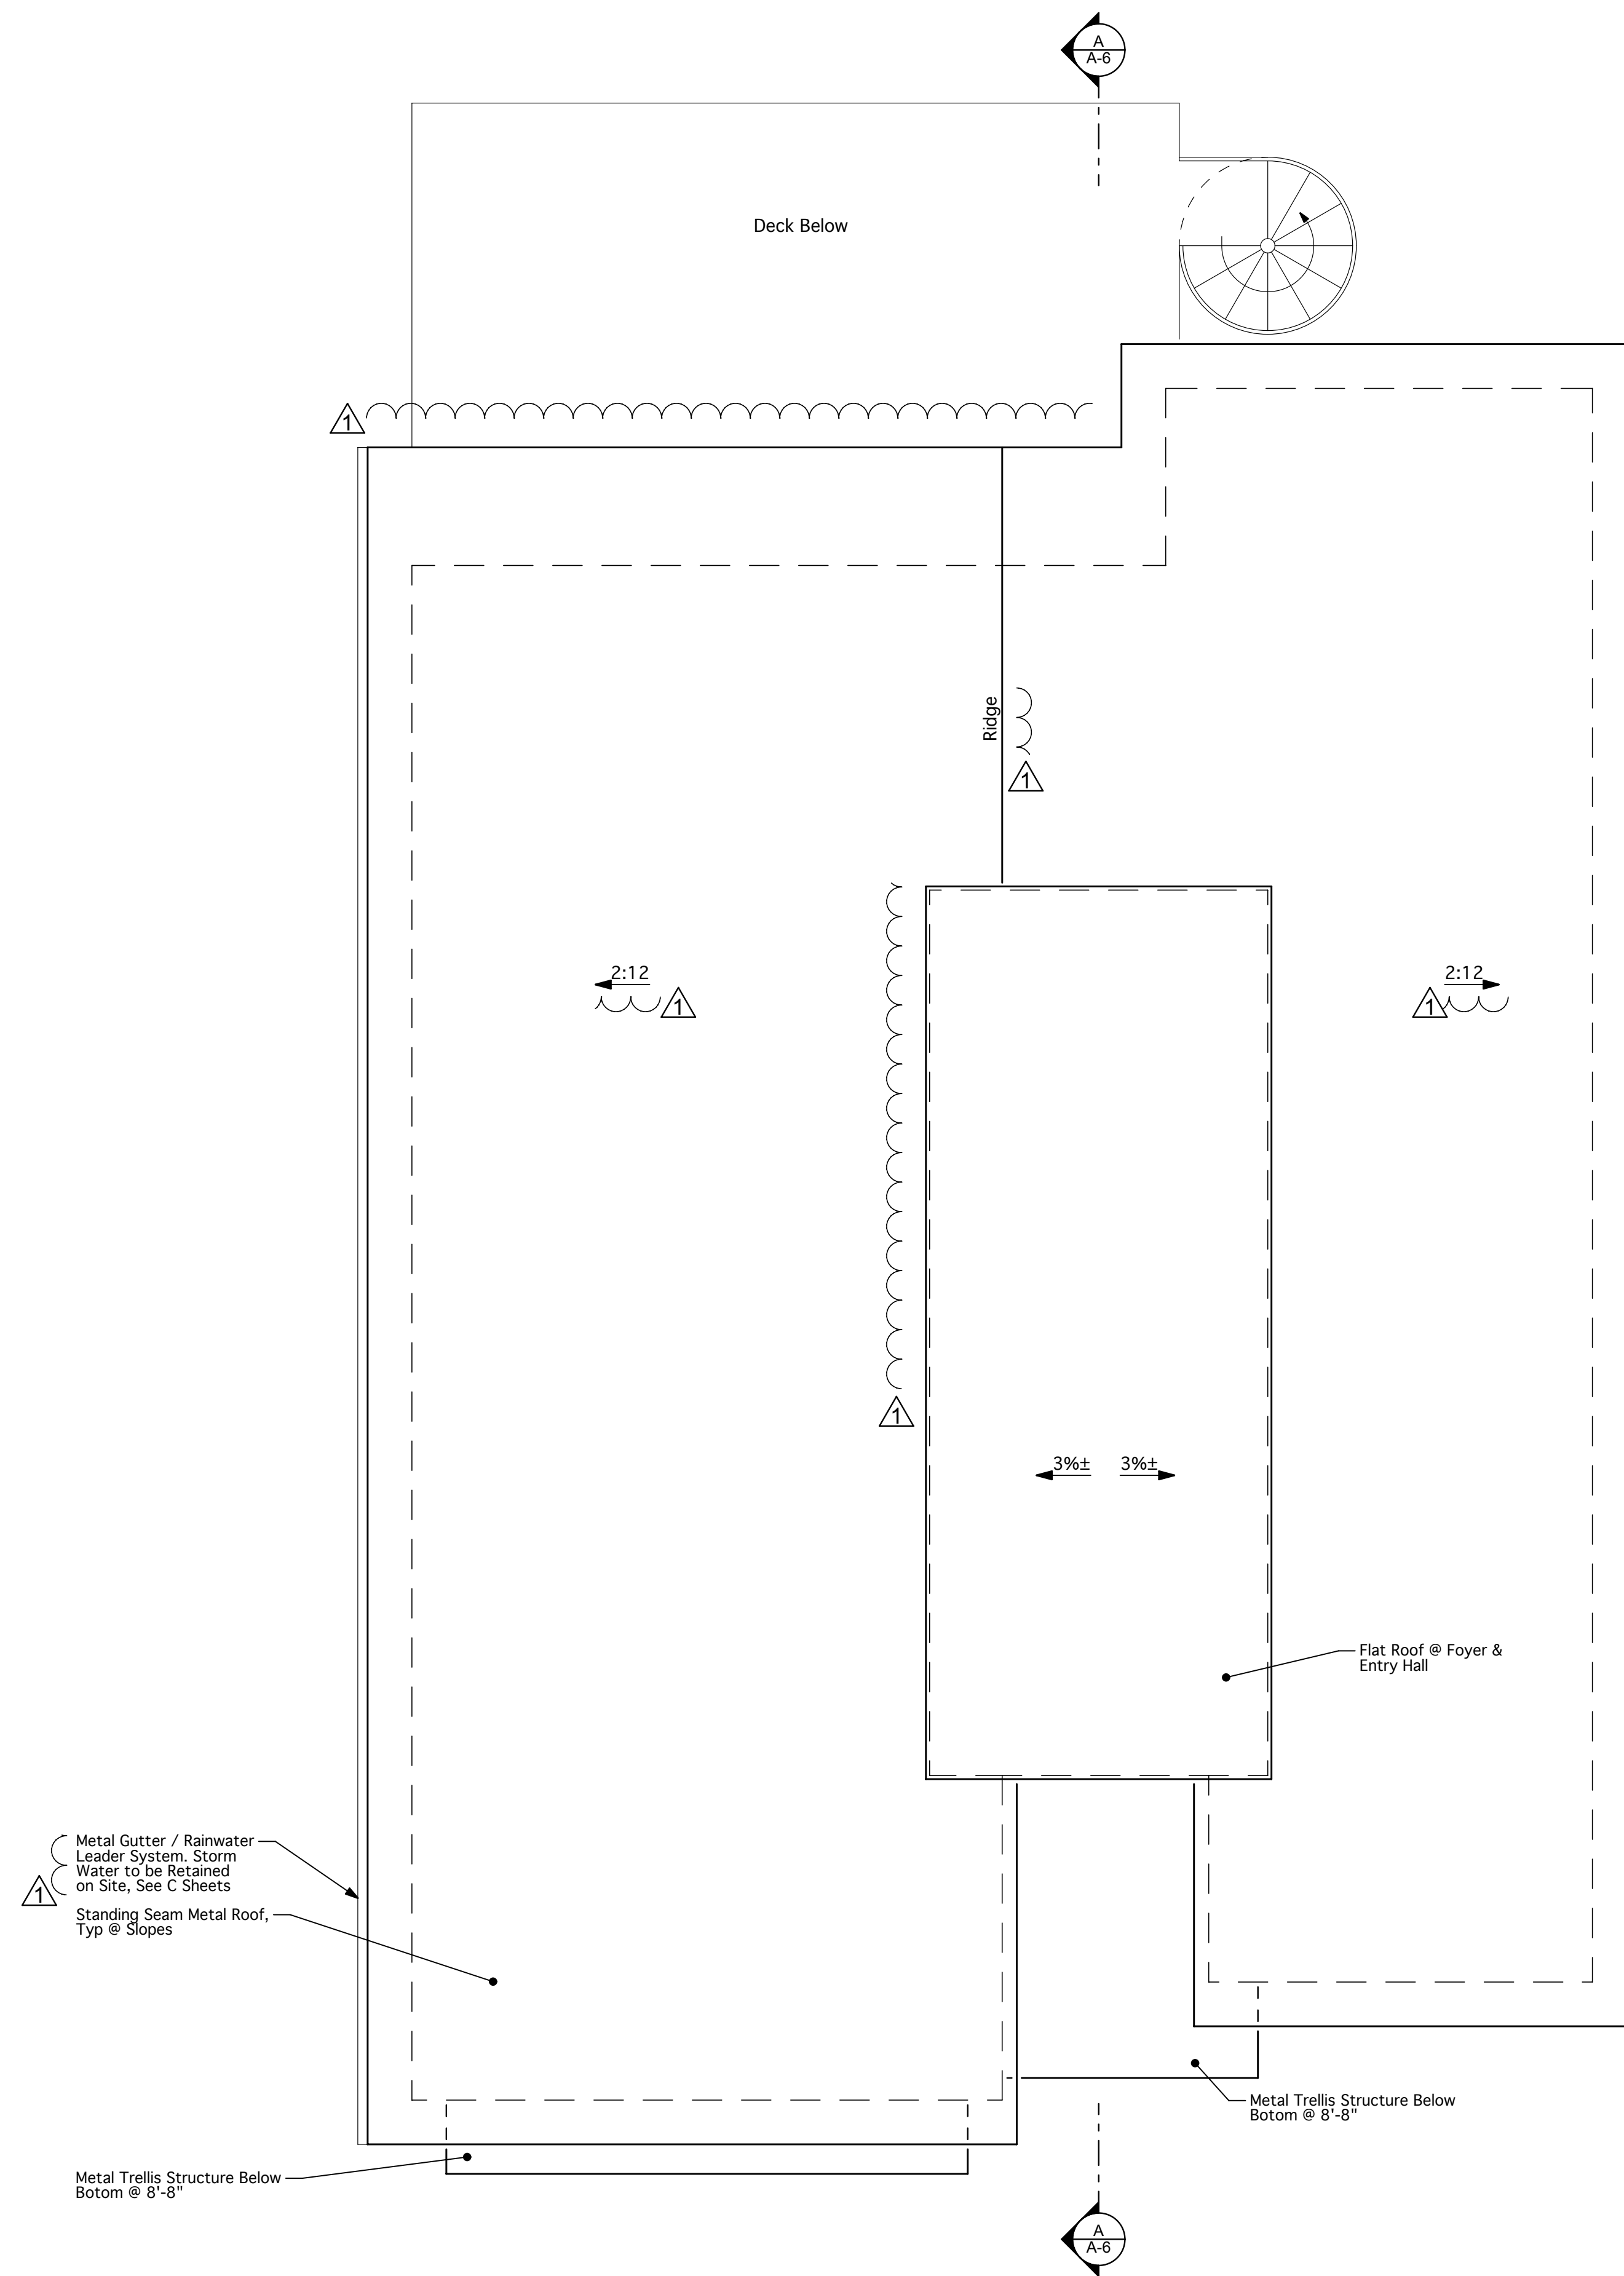

ROOF PLAN

Field Verify All Dimensions & Conditions Prior to Commencing Work.

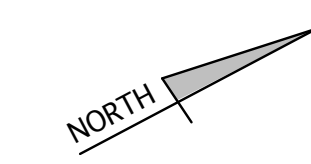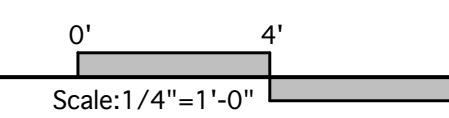

1615 Westwood Drive
San Jose, CA 95125
Phone: 408-209-5152
terry@tjmar-arch.com

TERRY J. MARTIN ASSOCIATES, A.I.A.
RESIDENTIAL & COMMERCIAL ARCHITECTURE
License # 623221

Dates & Revisions	
Architectural Design Review Resubmittal	08/05/2022
Architectural Design Review Submittal	05/02/2022
Rev. Description	Date:

Project


Martin-Weiss Residence
Custom Residence
52 West Summit Drive
Emerald Hills, CA 94062

Print Date: 08/05/2022
Project: #21034
Scale: 1/4" = 1'
Drawn by: TJ, RTP



Sheet Title:

ROOF PLAN



A-4

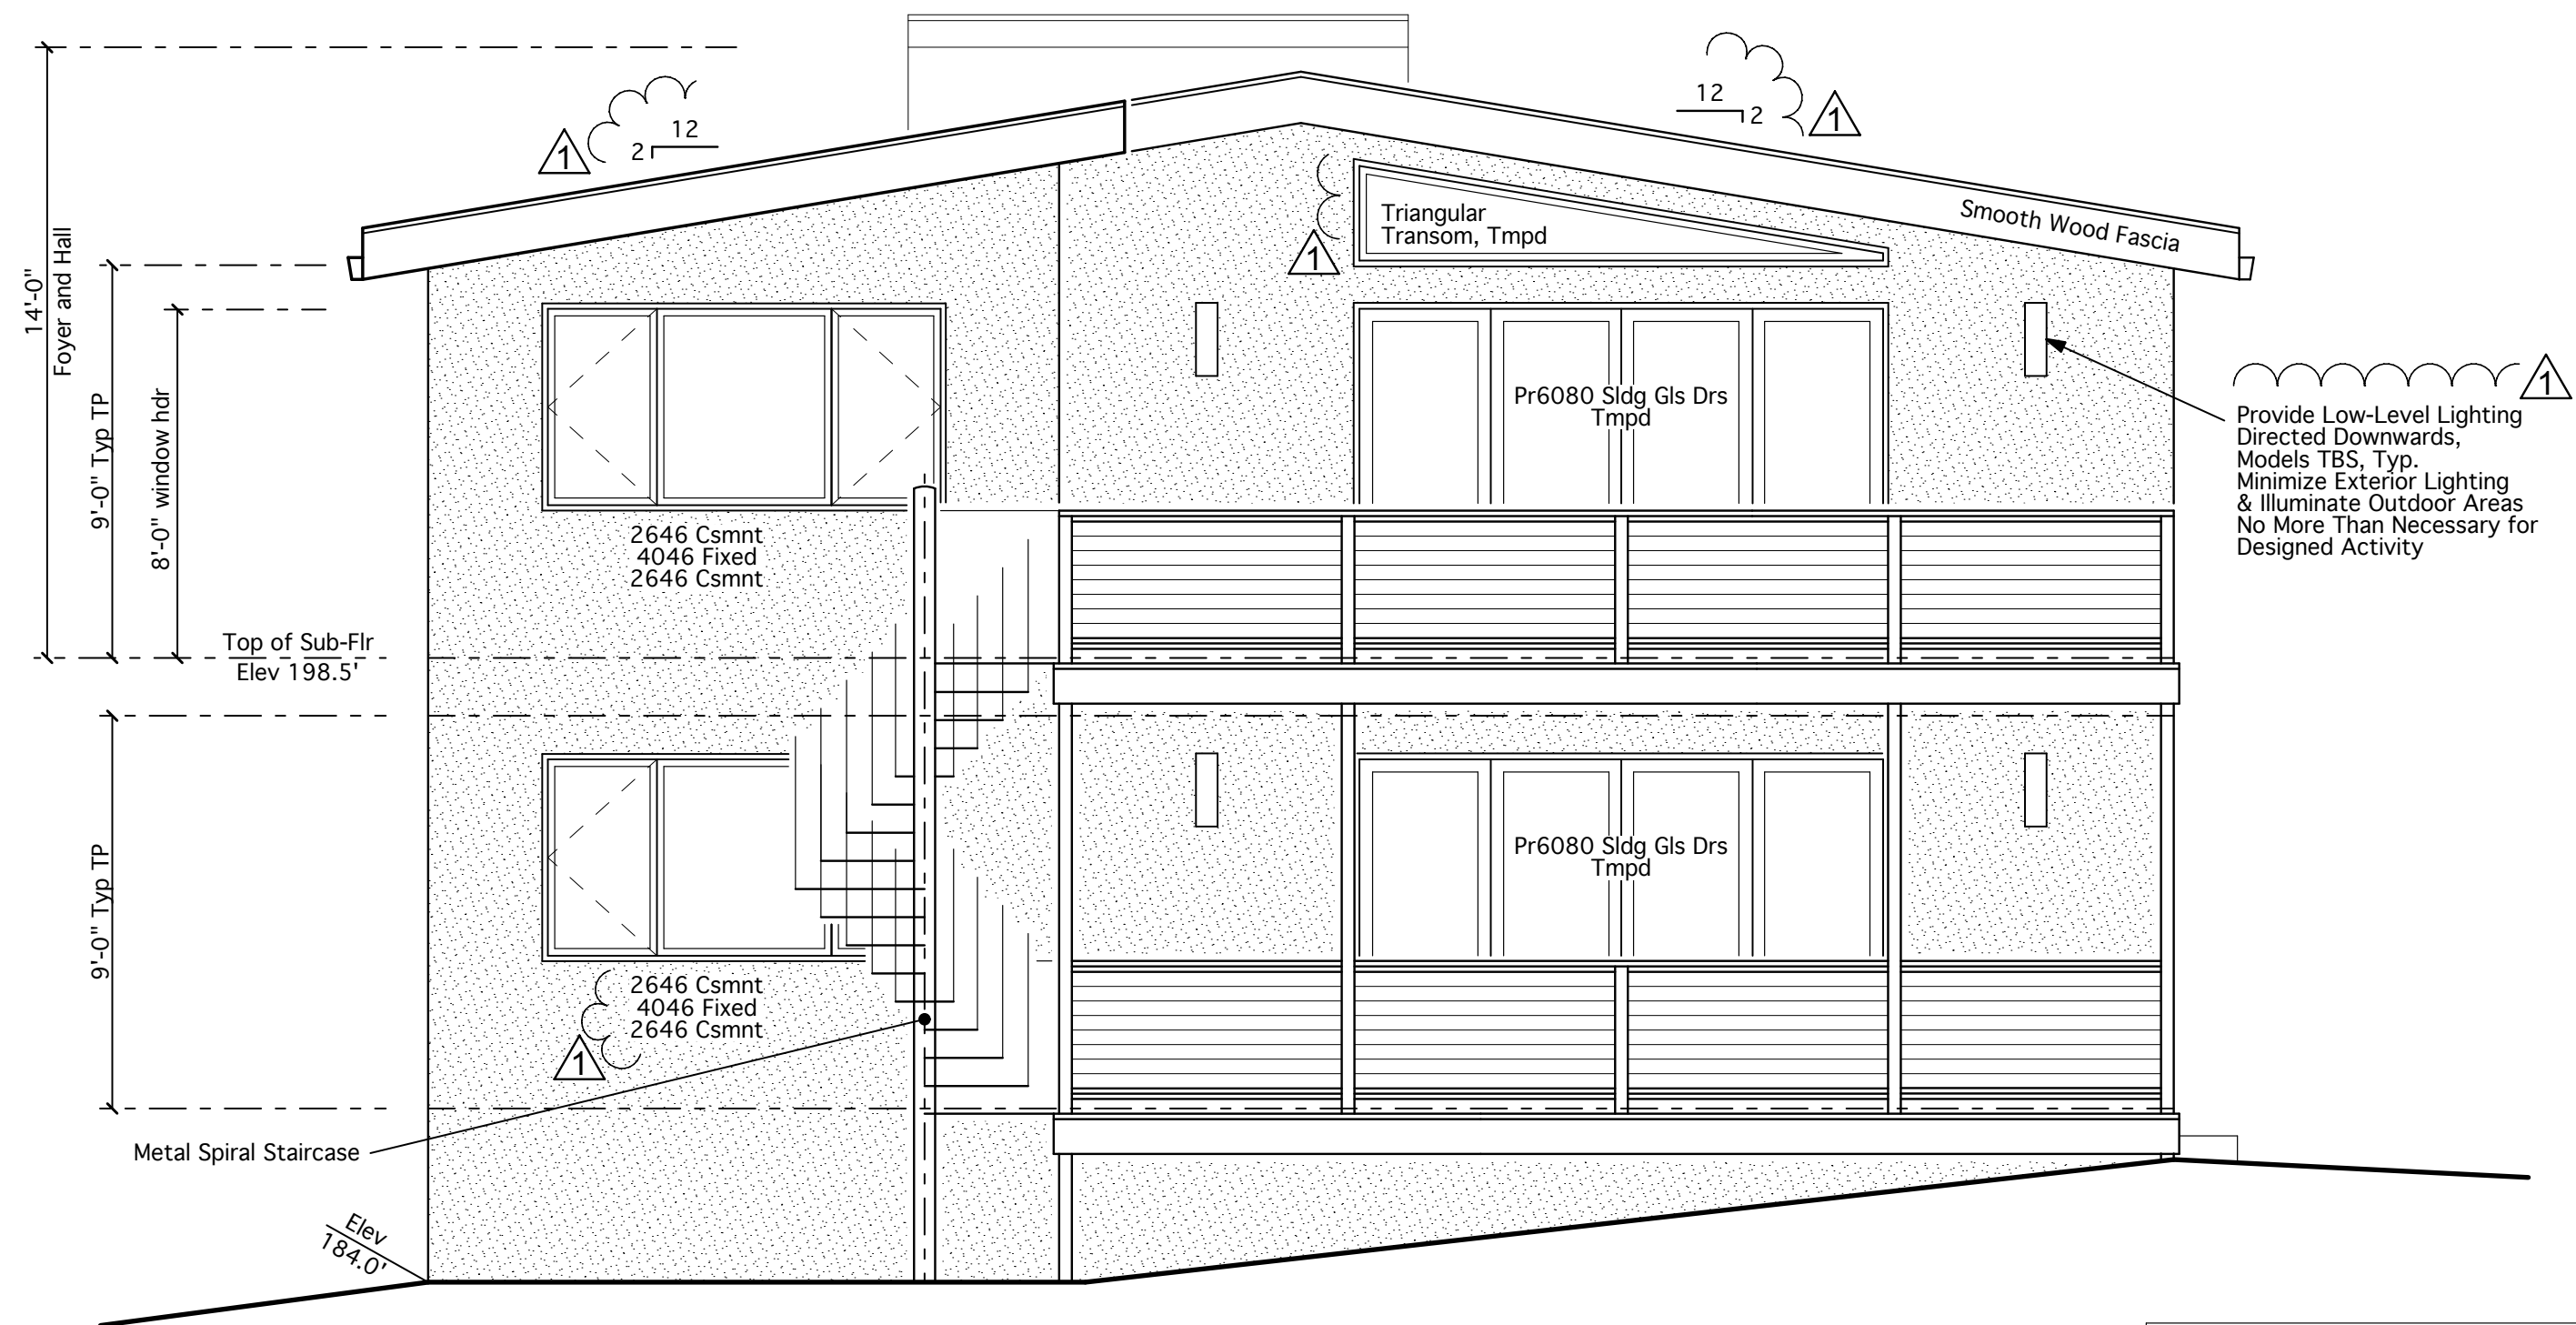



REAR ELEVATION

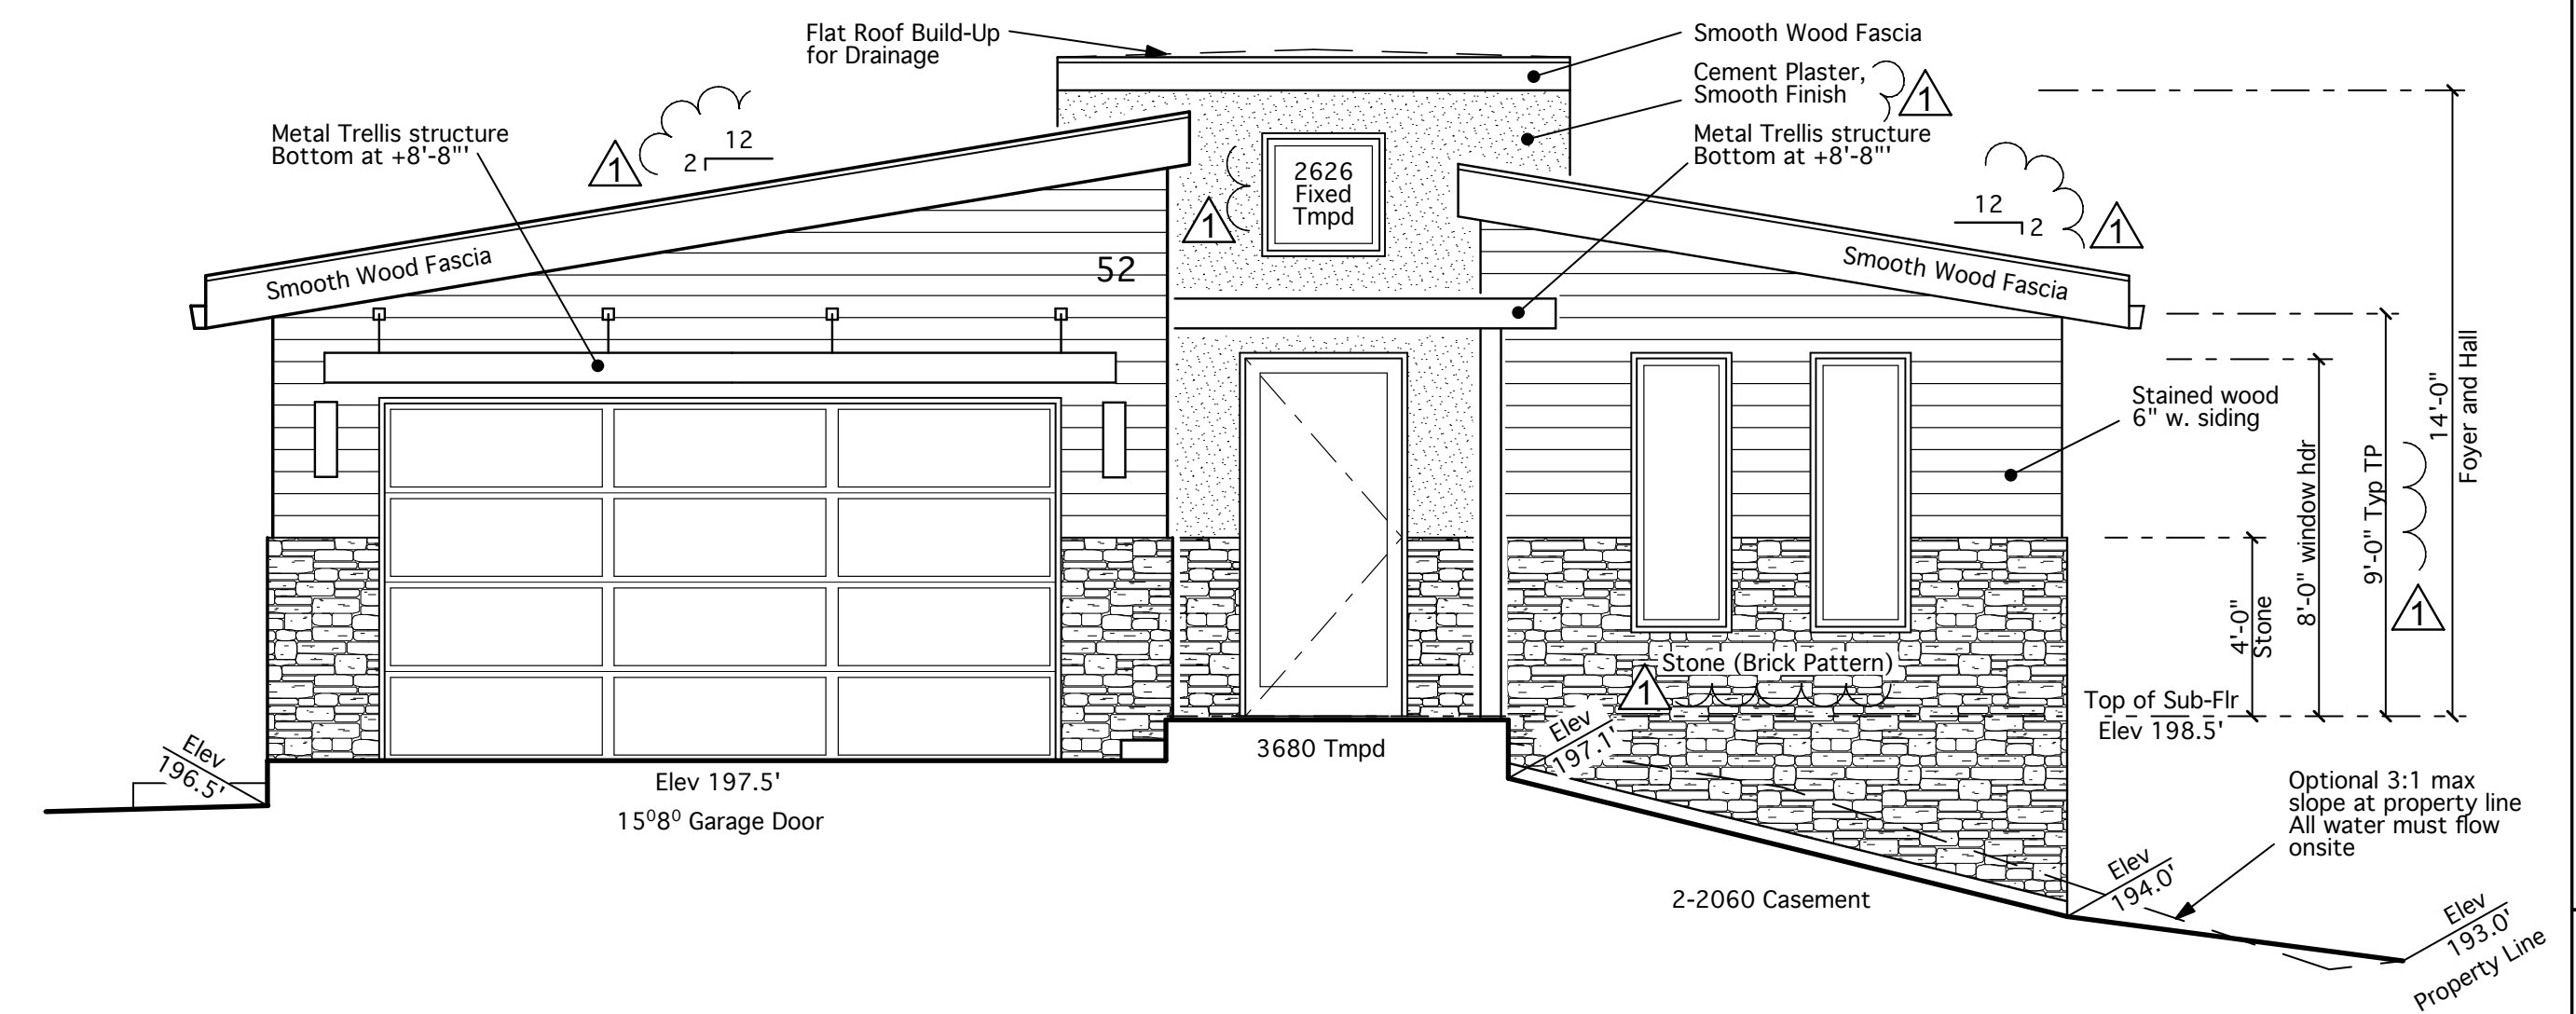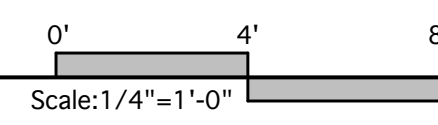


FRONT ELEVATION

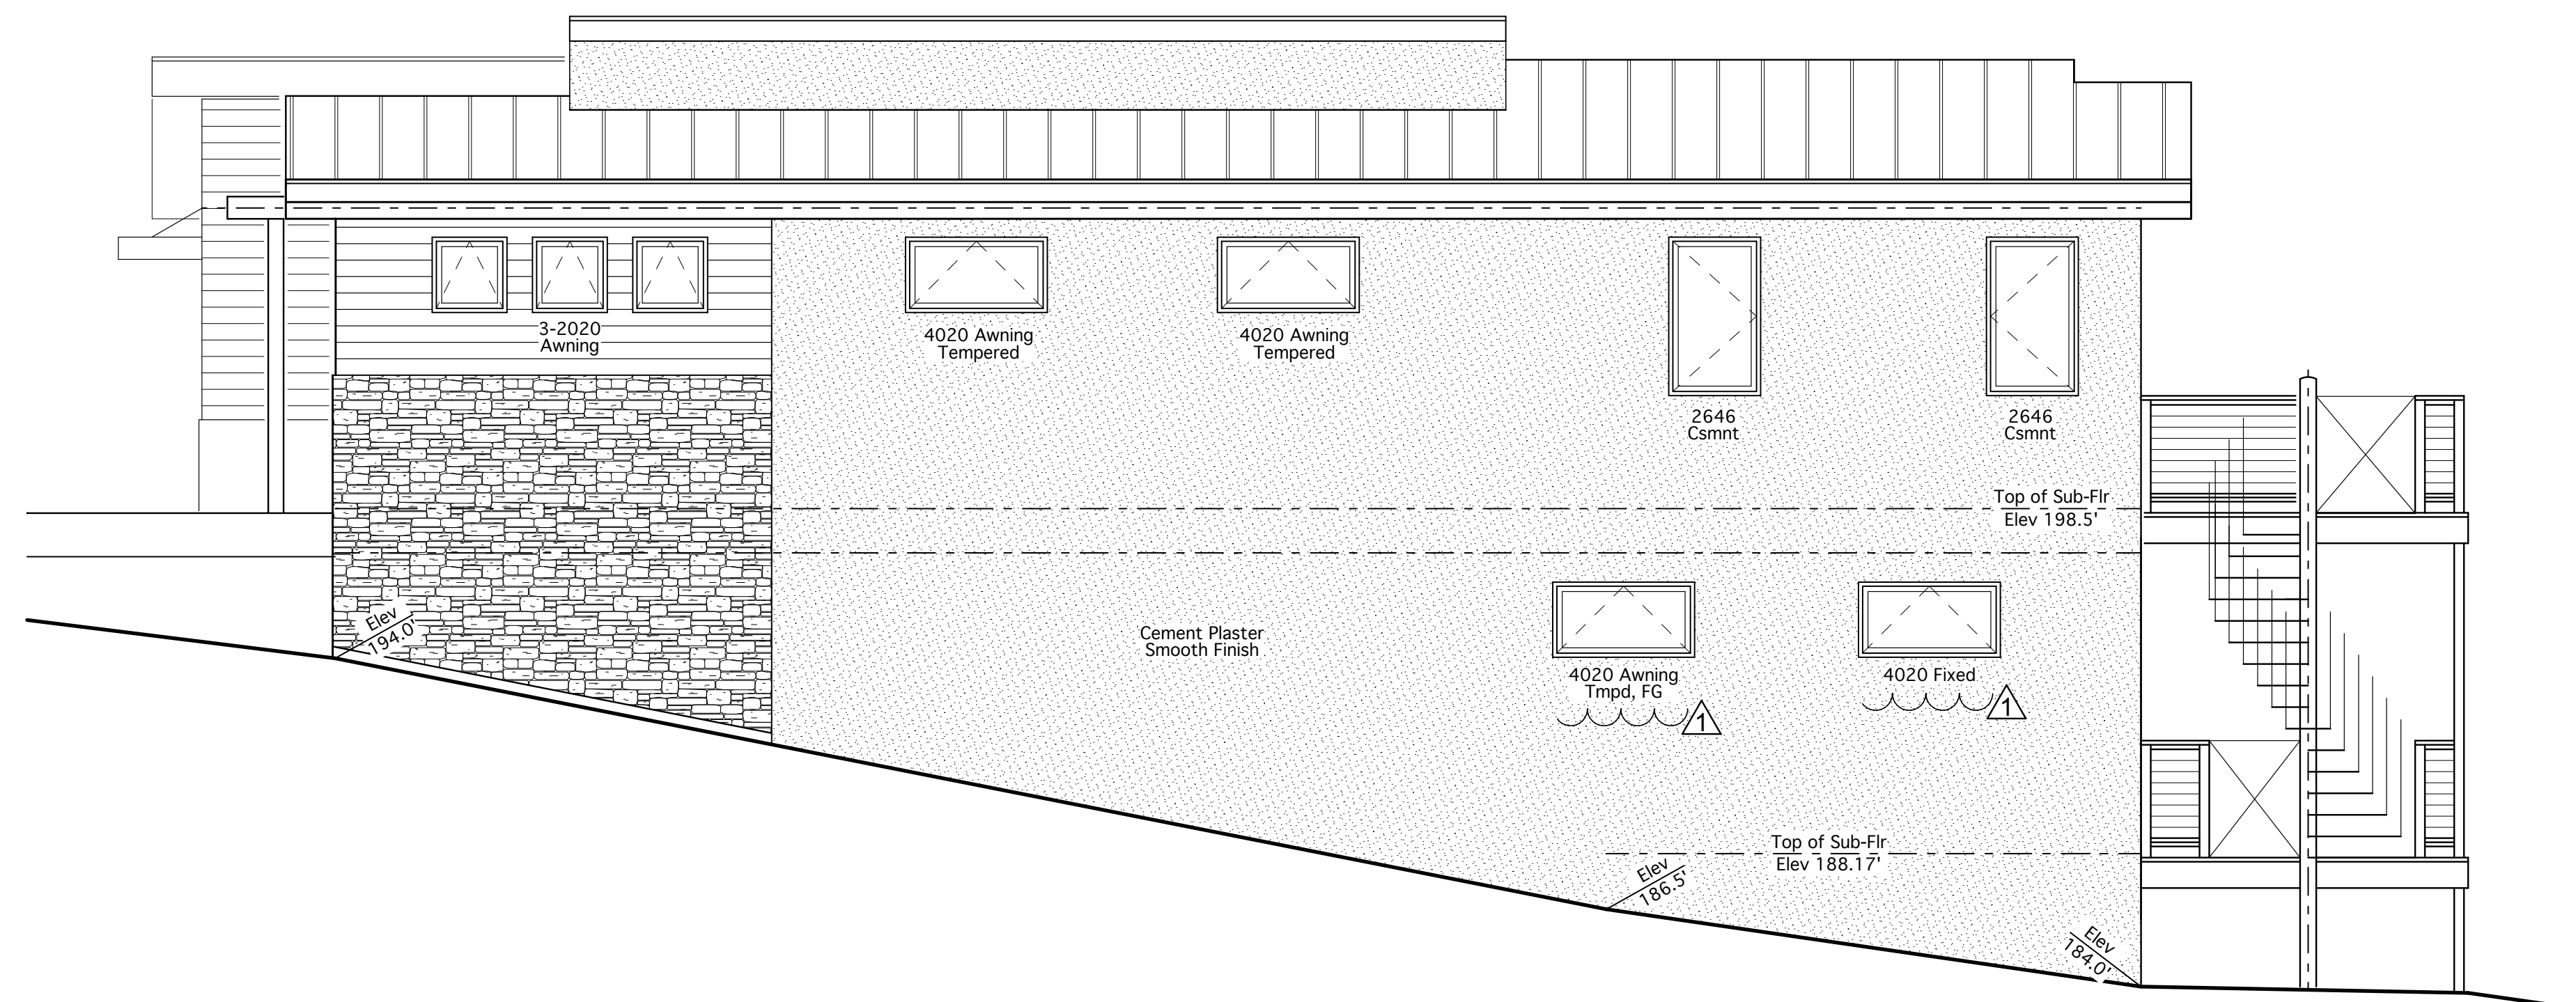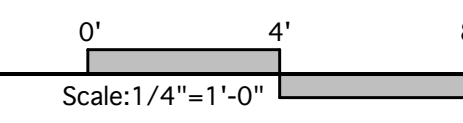

RIGHT SIDE ELEVATION

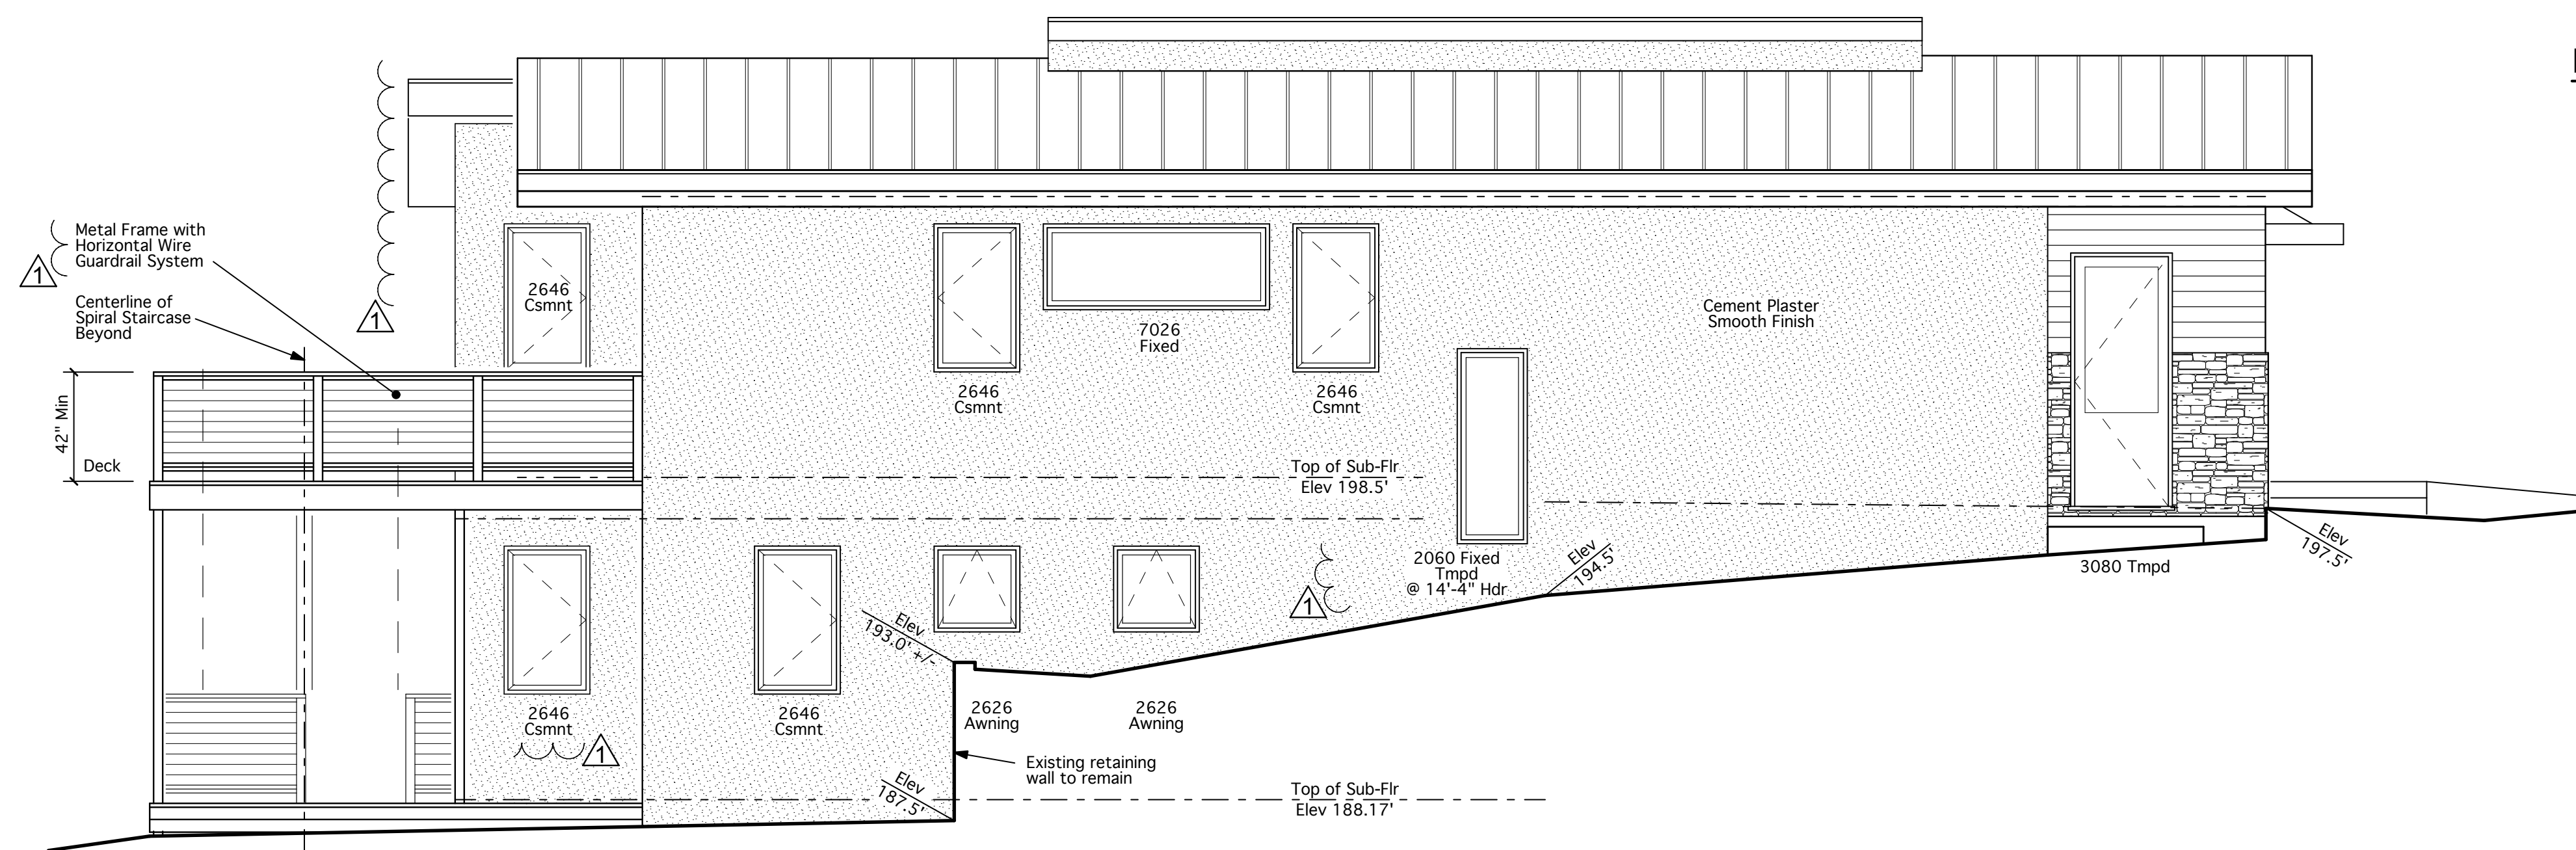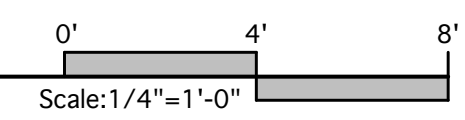

LEFT SIDE ELEVATION

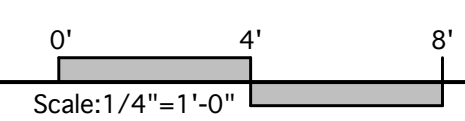

1615 Westwood Drive
 San Jose, CA 95125
 Phone: 408-209-5152
 terry@mar-arch.com

TERRY J. MARTIN ASSOCIATES, A.I.A.
 RESIDENTIAL & COMMERCIAL ARCHITECTURE
 License # 423221

Dates & Revisions	
Architectural Design Review Resubmittal	08/05/2022
Architectural Design Review Submittal	05/02/2022


Rev. Description
 Date:

Martin-Weiss Residence
 Custom Residence
 52 West Summit Drive
 Emerald Hills, CA 94062

Print Date: 08/05/2022
 Project: #21034
 Scale: 1/4" = 1"
 Drawn by: TJ, RTP

Sheet Title:
EXTERIOR ELEVATIONS

A-5

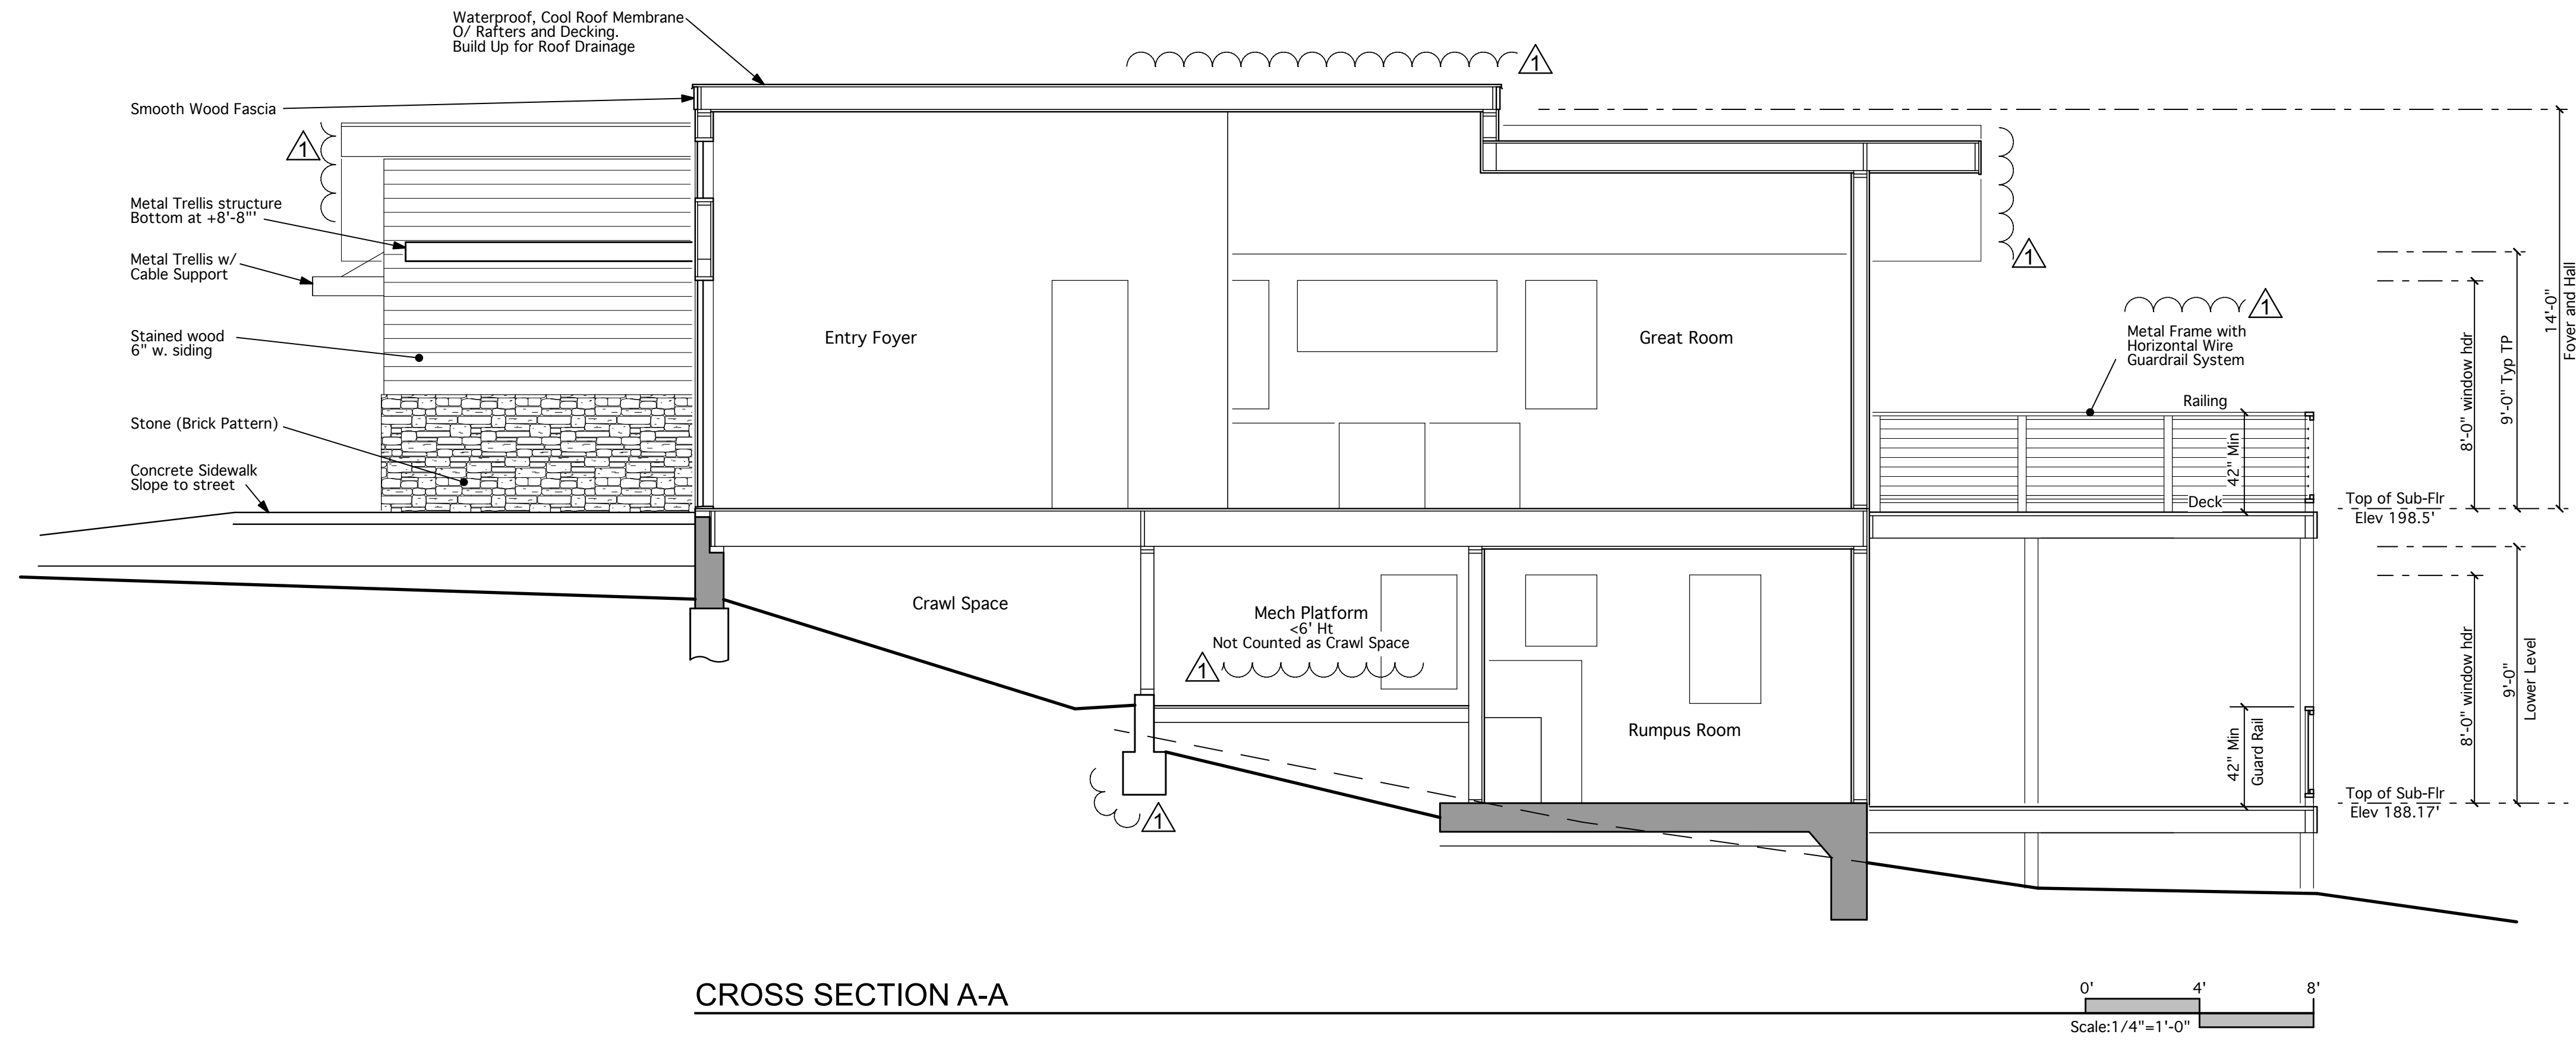

CROSS SECTION A-A

1615 Westwood Drive
San Jose, CA 95125
Phone: 408-209-5152
terry@tjmar-arch.com

TERRY J. MARTIN ASSOCIATES, A.I.A.
RESIDENTIAL & COMMERCIAL ARCHITECTURE
License # 423221

Dates & Revisions	
Architectural Design Review Resubmittal	08/05/2022
Architectural Design Review Submittal	05/02/2022
Rev. Description	Date:

Project

Martin-Weiss Residence
Custom Residence
52 West Summit Drive
Emerald Hills, CA 94062

Print Date: 08/05/2022
Project: #21034
Scale: 1/4" = 1'
Drawn by: TJ

Sheet Title:

CROSS SECTION
A-A

A-6